
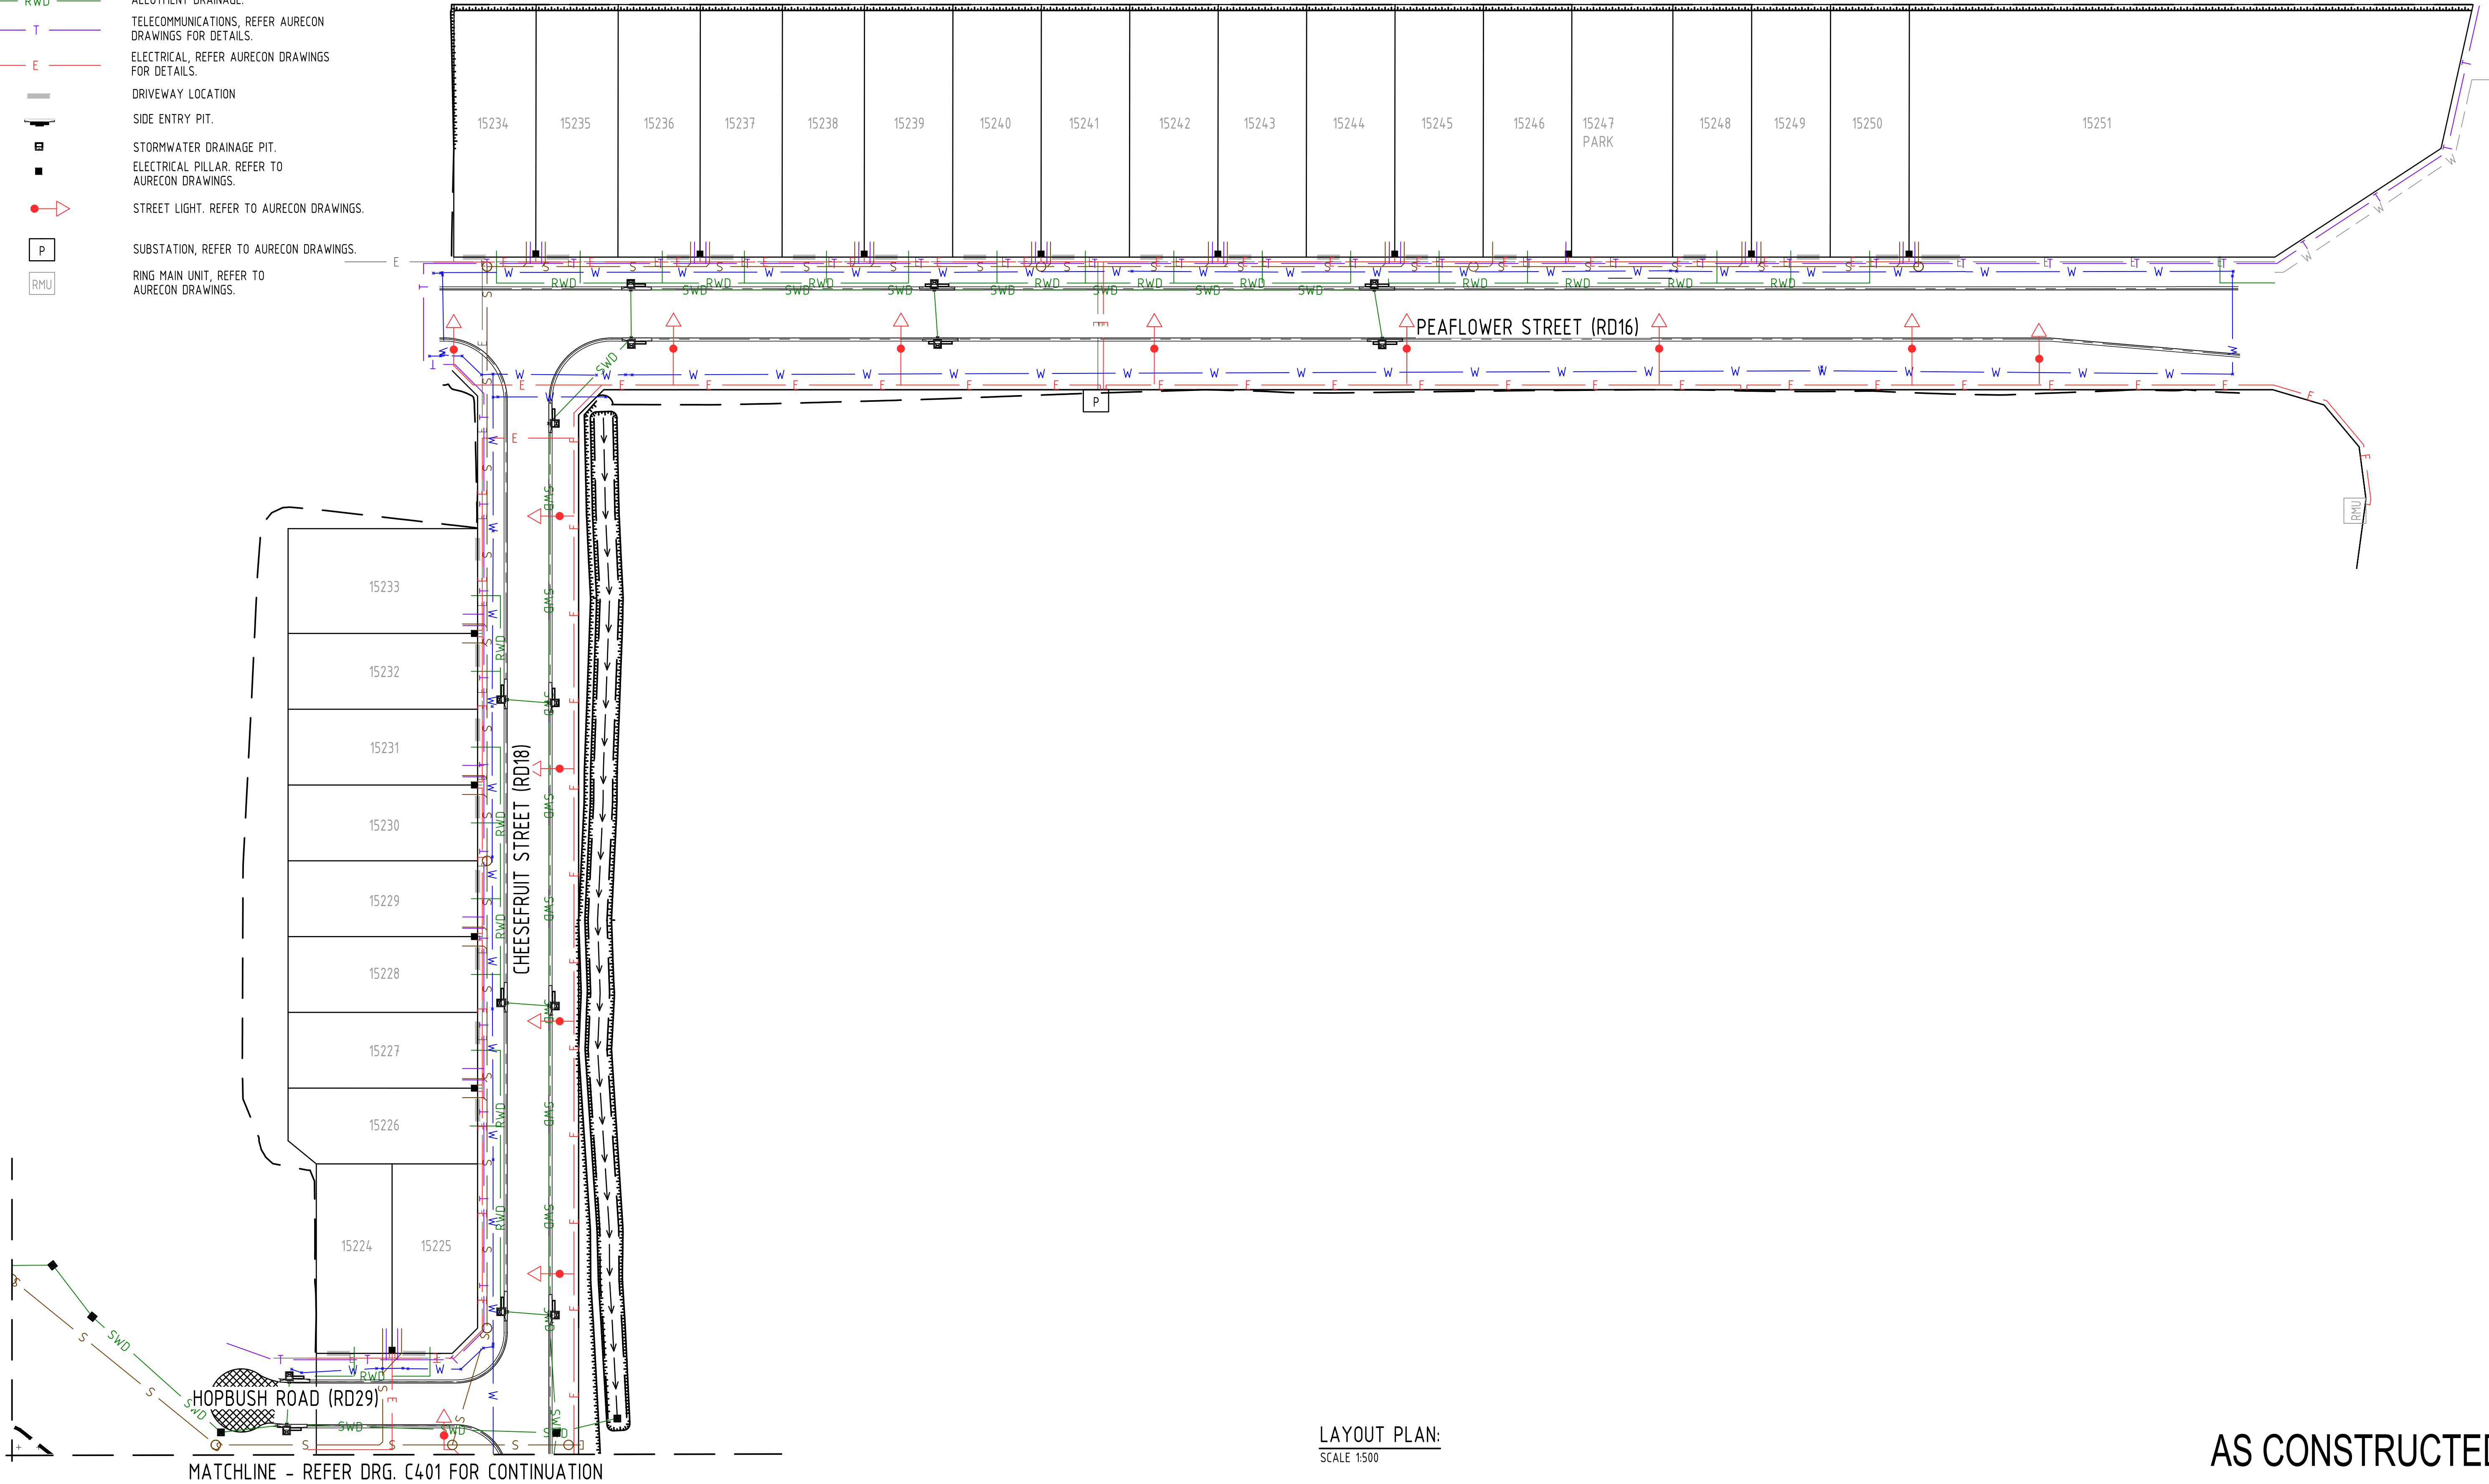


LEGEND


- S SEWER MAIN  
W WATER MAIN  
SWD STORMWATER DRAINAGE.  
RWD ALLOTMENT DRAINAGE.  
T TELECOMMUNICATIONS, REFER AURECON DRAWINGS FOR DETAILS.  
E ELECTRICAL, REFER AURECON DRAWINGS FOR DETAILS.  
DRIVEWAY LOCATION  
SIDE ENTRY PIT.  
STORMWATER DRAINAGE PIT.  
ELECTRICAL PILLAR. REFER TO AURECON DRAWINGS.  
STREET LIGHT. REFER TO AURECON DRAWINGS.  
P SUBSTATION, REFER TO AURECON DRAWINGS.  
RMU RING MAIN UNIT, REFER TO AURECON DRAWINGS.

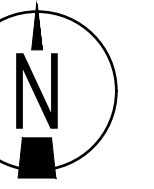

LAYOUT PLAN:  
SCALE 1:500

AS CONSTRUCTED

Rev	Date	Description	By	Chk
0	19.02.19	AS CONSTRUCTED	JMB	SW

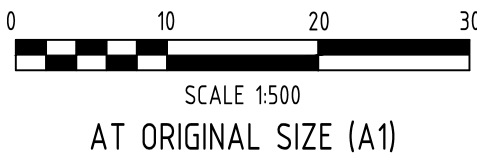


**Darwin Office**  
Tenancy 3, Level 1, 5 Edmunds Street,  
Darwin, Northern Territory 0800, Australia  
GPO Box 2422, Darwin, Northern Territory 0801  
T 1300 657 402 F +617 3871 2266  
E info@adgce.com W www.adgce.com  
BRISBANE / SYDNEY / MELBOURNE / GOLD COAST / SUNSHINE COAST / DARWIN / PERTH

Client COSTOJIC PTY LTD	Discipline CIVIL	Status AS CON	Title MASTER PLANNING SERVICES STAGE 3E LAYOUT PLAN SHEET 1 OF 2
Project Name ZUCCOLI ASPIRE STAGE 3E CIVIL WORKS	Designed By TM	Checked By SW	Approved By CJM
	Project No. 20696_3E	Drawn By JMB	Scale at A1 1:500
The concepts and information contained in this document are the copyright of ADG Engineers (Aust) Pty Ltd. Use or copying of the document in whole or in part without the written permission of ADG Engineers (Aust) Pty Ltd constitutes an infringement of copyright. Do not scale drawings. If in doubt, ask!			Drawing No. C400
			Revision 0



NOTES

1. FOR LEGEND AND NOTES REFER TO DRG No. C400

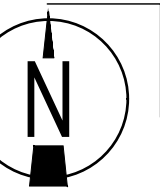


MATCHLINE - REFER DRG. C401 FOR CONTINUATION



LAYOUT PLAN:  
SCALE 1:500

AS CONSTRUCTED

Rev	Date	Description	By	Chk
0	19.02.19	AS CONSTRUCTED	JMB	SW

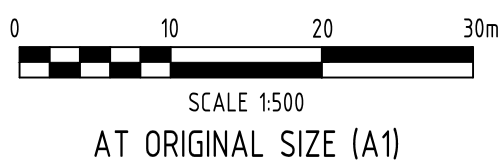

Client COSTOJIC PTY LTD		Discipline CIVIL		Status AS CON	Title MASTER PLANNING SERVICES STAGE 3E LAYOUT PLAN SHEET 2 OF 2	
Project Name ZUCCOLI ASPIRE STAGE 3E CIVIL WORKS		Designed By TM	Checked By SW	Approved By CJM		
		Project No. 20696_3E	Drawn By JMB	Scale at A1 1:500		
The concepts and information contained in this document are the copyright of ADG Engineers (Aust) Pty Ltd. Use or copying of the document in whole or in part without the written permission of ADG Engineers (Aust) Pty Ltd constitutes an infringement of copyright. Do not scale drawings. If in doubt, ask!						Drawing No. C401