
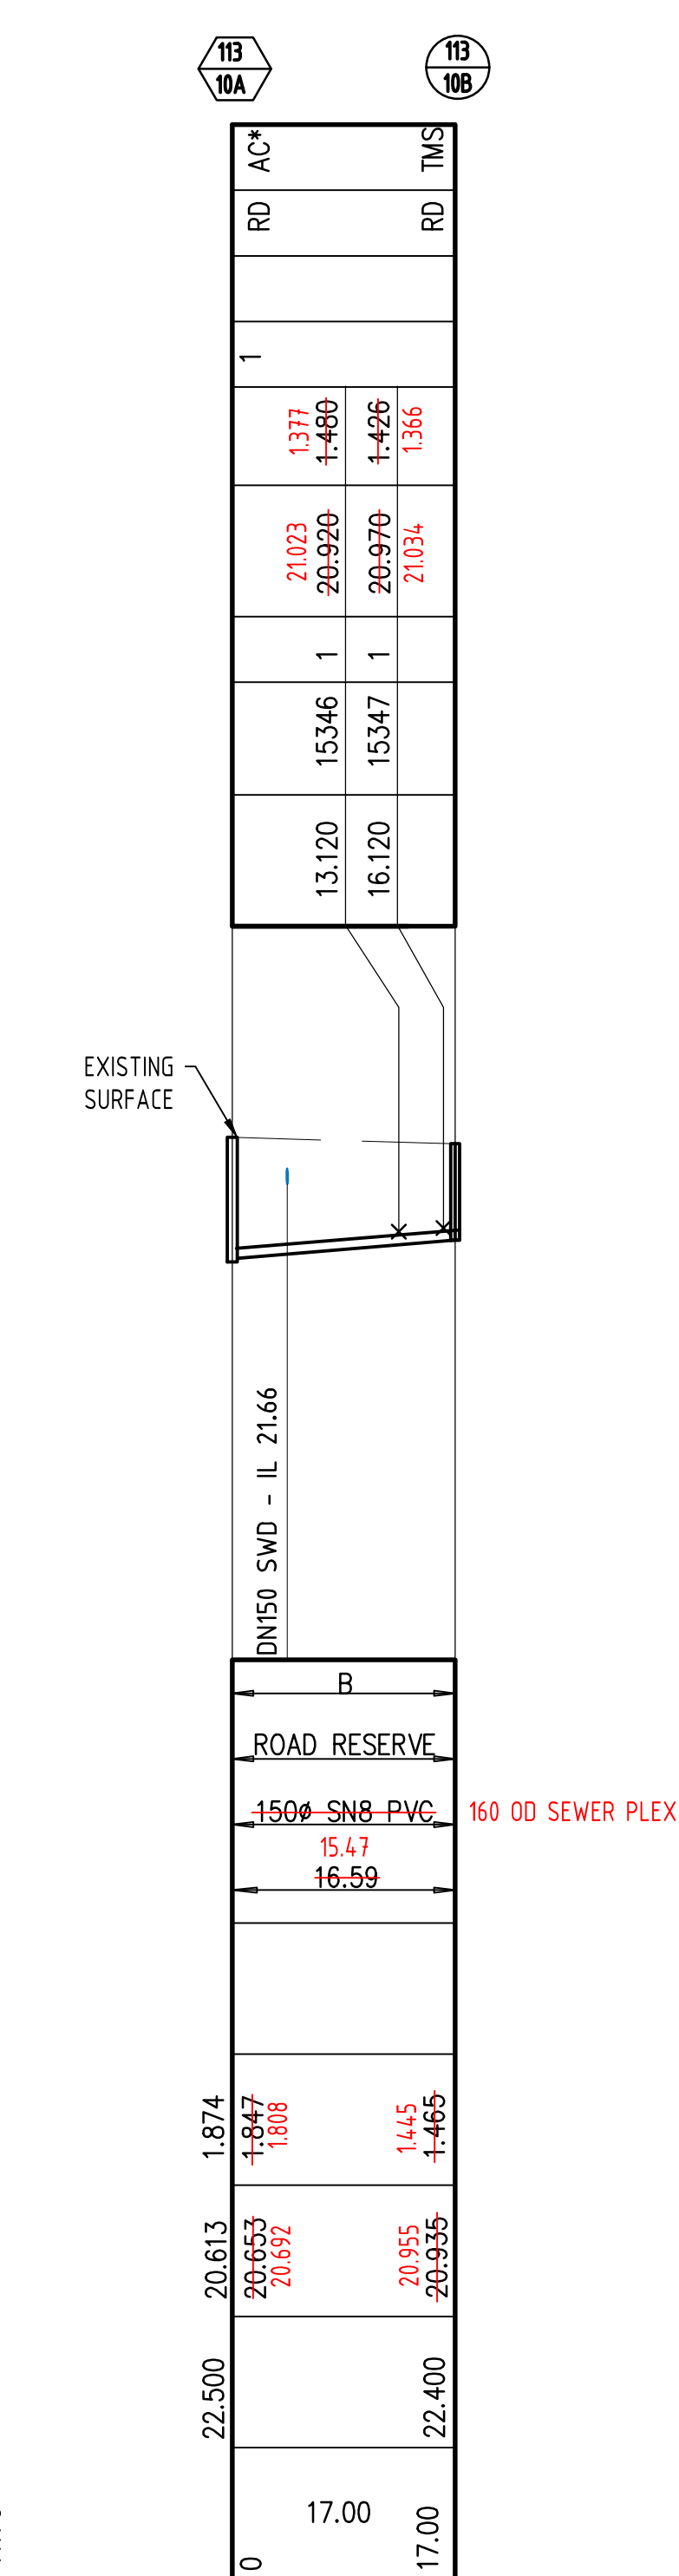
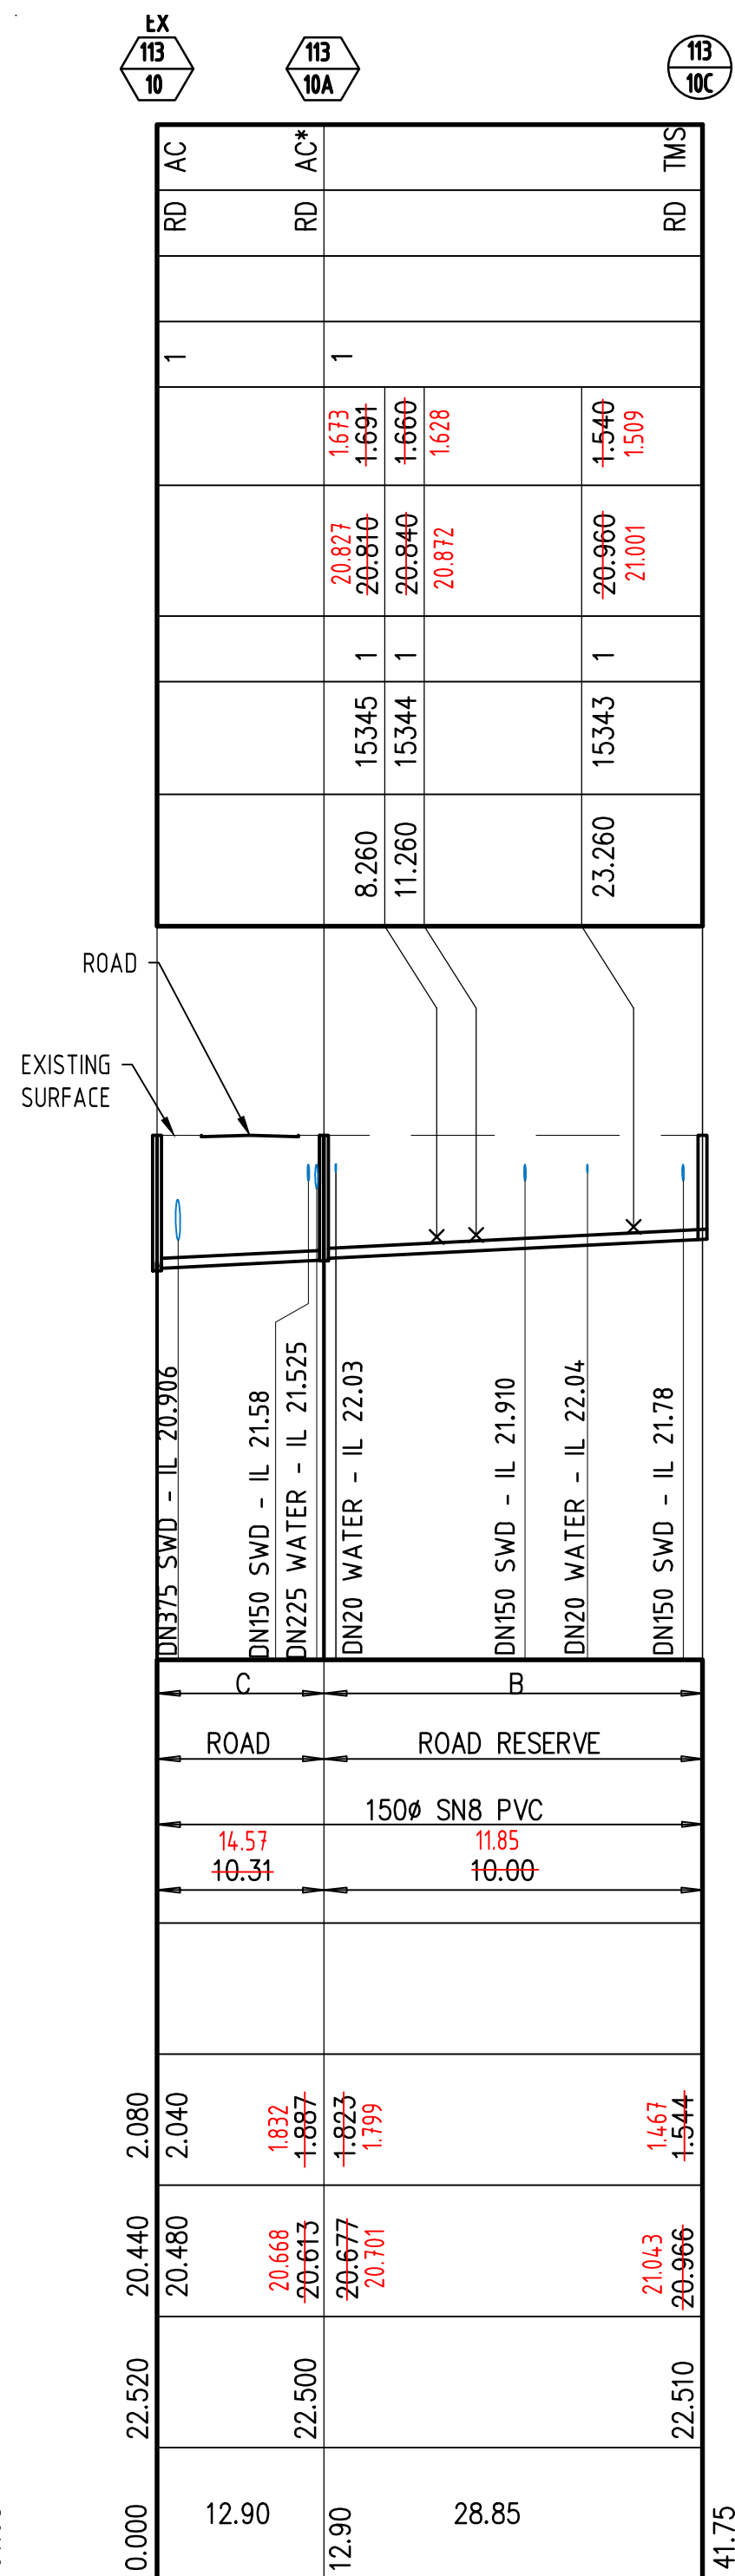


- NOTES:
- REFER TO B20-12358 SEWER NOTES AND DETAILS FOR TRENCHING INFORMATION AND LOT CONNECTION DETAILS.
 - THRUST BORING TO BE DONE IN ACCORDANCE WITH PWC STANDARD DRAWING W1-1-33.

MANHOLE/END NAME	113 9A	113 9A
MANHOLE TYPE	RD AC	RD TMS
LID TYPE	RD	RD
JUNCTION LINE		
DROP TYPE	1	
DEPTH TO HC		1.629 1.156 1.156 1.655
HOUSE CONNECTION INVERT LEVEL	21.371 21.844 21.844 21.345	2 2 2
HC TYPE		
HC LOT No	15340 15341	2
CH. FROM D/S MH	57.759 60.759	

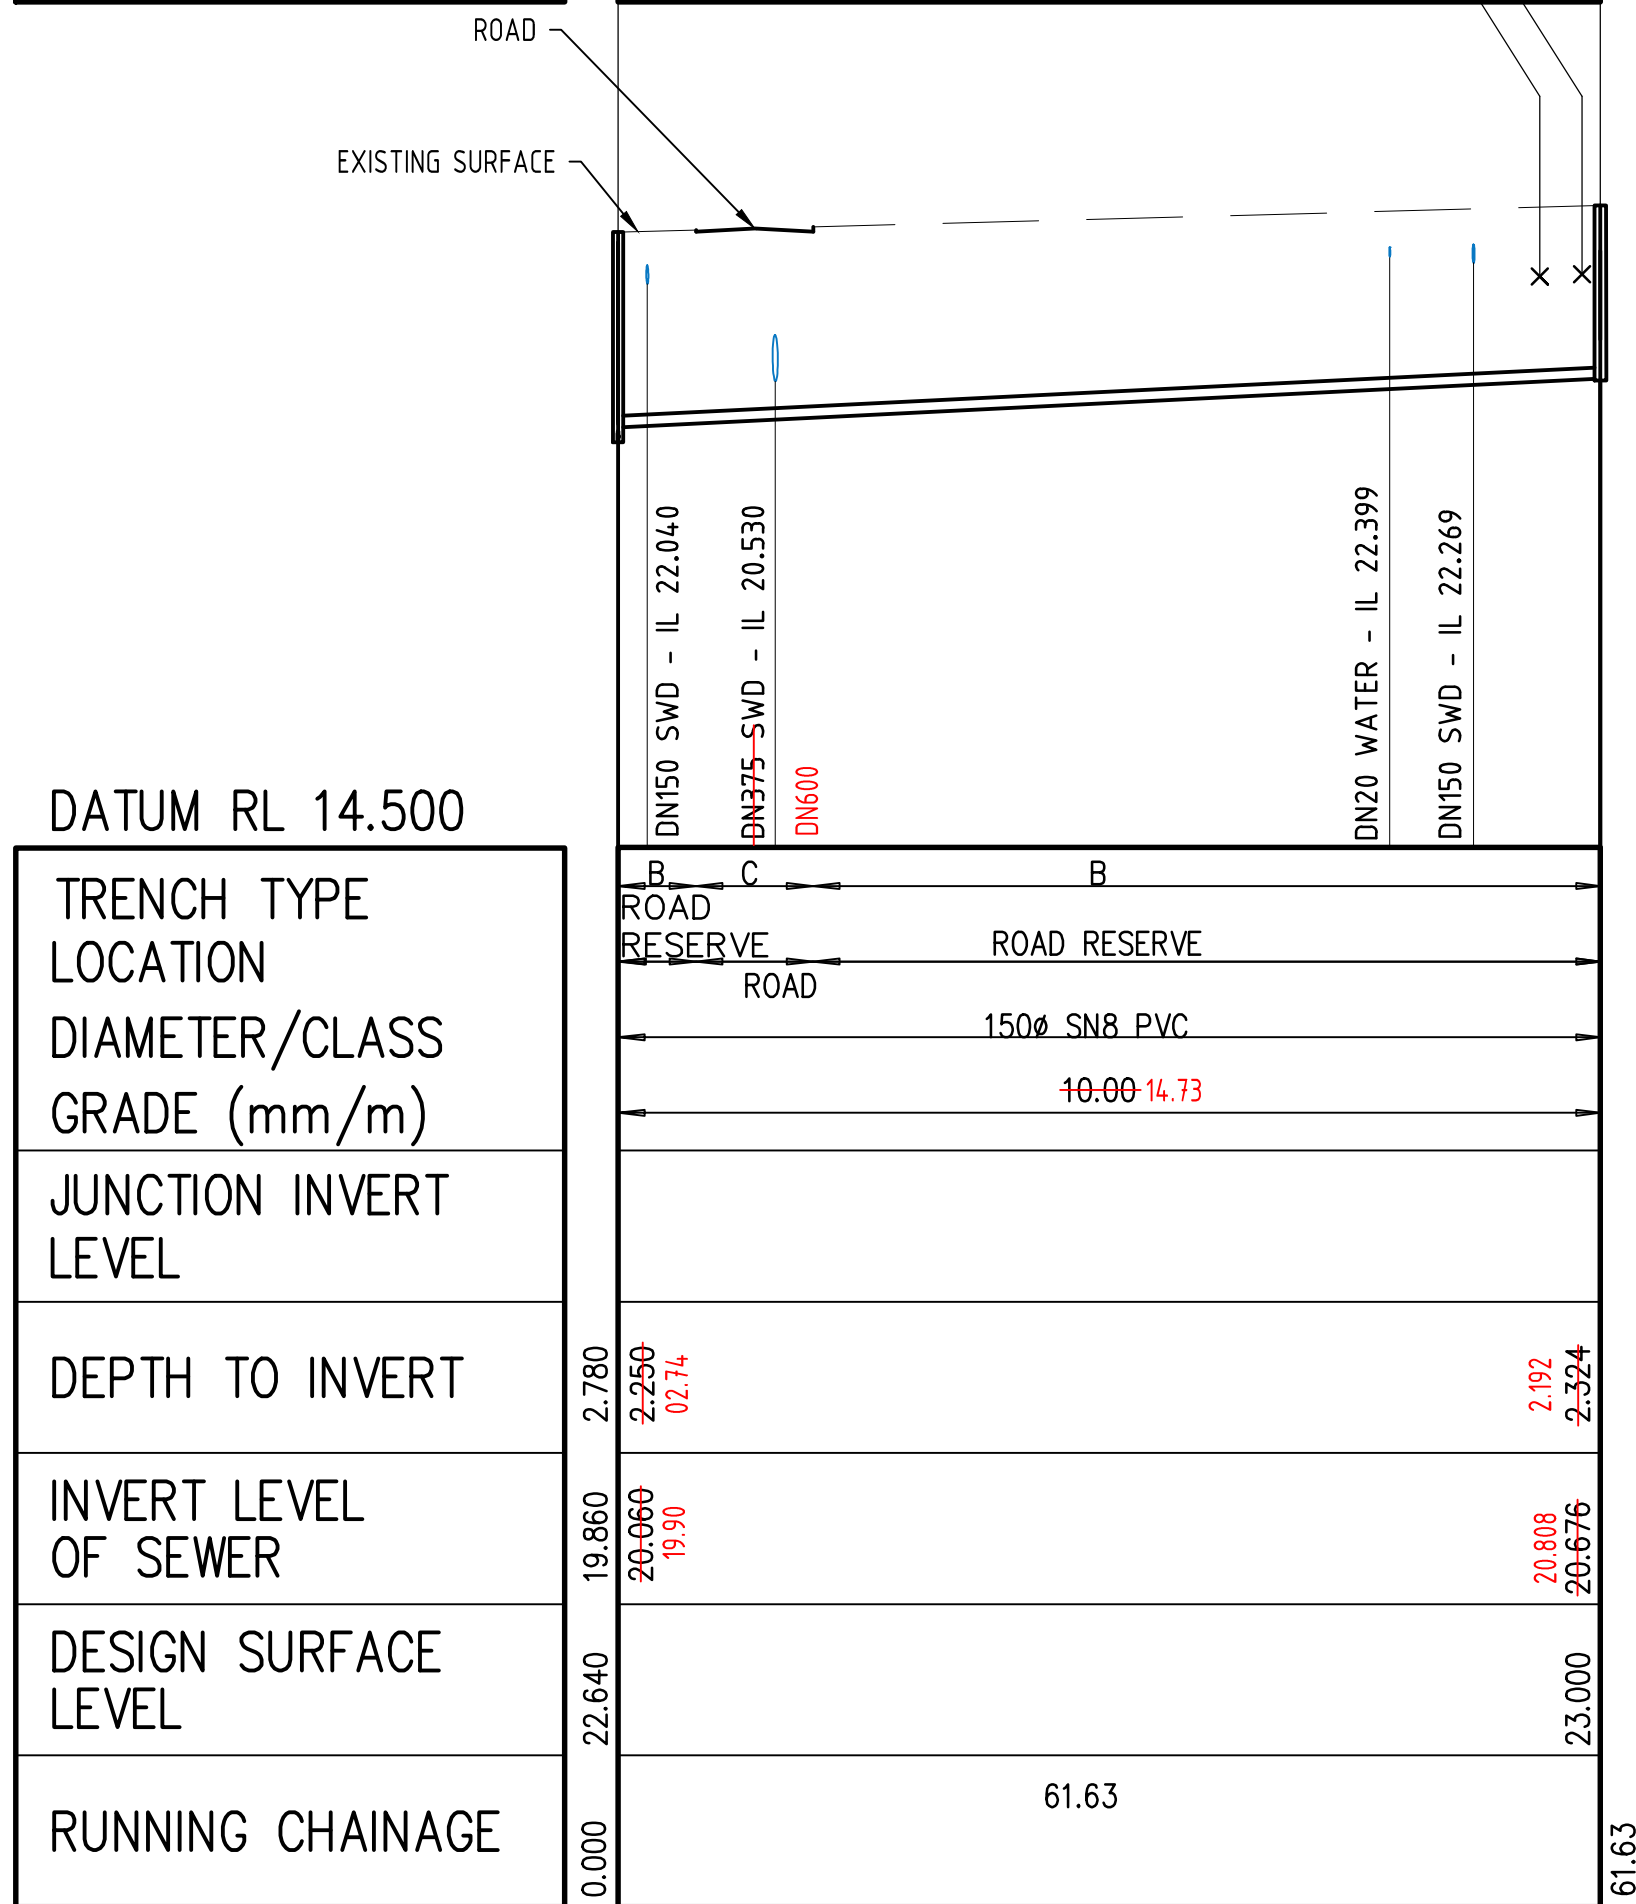

SEWER STRUCTURE SETOUT TABLE		
STRUCTURE I.D	EASTING	NORTHING
113/10B	4060.083	1570.041
113/10A	4047.276	1558.866
113/10C	4020.604	1547.871
113/9A	3984.600	1586.274

DESIGN CERTIFICATION

CERTIFIER'S NAME: SAM WARNER
PWC ACCREDITATION CODE: DESCRTBL69
DATE: 20.05.21 SIGNATURE: _____

STRUCTURE TYPES:
AC = ACCESS CHAMBER
AC* = ACCESS CHAMBER OFFSET, REFER
DETAIL ON DRG B20-12358.
MS = MAINTENANCE SHAFT
TMS = TERMINAL MAINTENANCE SHAFT

COVER TYPES:
RD = RECTANGULAR CLASS D
CD = CIRCULAR CLASS D

HOUSE CONNECTION DETAILS:
EXACT HOUSE CONNECTION LOCATIONS ARE
TO BE CONFIRMED ON SITE FOLLOWING
PRELIMINARY LOT PEGGING.


PERMISSION TO USE FOR CONSTRUCTION PURPOSES ONLY

SIGNED _____ DATE _____

ON BEHALF OF WATER SERVICES FOR THE INCORPORATION
INTO POWER AND WATER CORPORATION'S NETWORK.

This permission to use this approved design is given on the
basis that the developer and/or consultant is not absolved
from full responsibility for the correctness and accuracy or
of the design and/or documents so associated.

This drawing is valid for 2 years from the date of signing

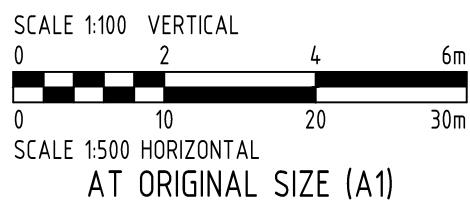

AS CONSTRUCTED

ADG PROJECT 20696 DRG No. 13356_505

NO	DESCRIPTION	DRN	DATE	CKD	APPD
6	AS CONSTRUCTED	SFH	20.05.21	JL	SW
5	ISSUED FOR CONSTRUCTION	JL	11.02.21	SW	SW
4	ISSUED FOR CONSTRUCTION	JL	23.11.20	SW	SW
3	ISSUED FOR APPROVAL	JL	18.11.20	SW	SW
2	ISSUED FOR APPROVAL	JL	12.11.20	SW	SW
1	ISSUED FOR CONSTRUCTION	JL	6.11.20	SW	SW
0	ISSUED FOR CONSTRUCTION	DT	28.09.20	SW	SW



Darwin Office
Tenancy 3, Level 1, 5 Edmonds Street,
Darwin, Northern Territory 0800, Australia
GPO Box 2422, Darwin, Northern Territory 0801
T + 1300 657 410 F +617 3871 2288
E info@adg.com.au W www.adg.com.au
BROOKLYN (DARWIN) GOLD COAST / MELBOURNE (NORTH)
BROOKLYN COAST / TOWNEY / TOOWOOMBA



WARNING
BEWARE OF SERVICES
THE LOCATIONS OF ALL EXISTING SERVICES ARE
APPROXIMATE ONLY AND THEIR EXACT POSITION
SHOULD BE PROVEN ON SITE. NO GUARANTEE IS
GIVEN THAT ALL EXISTING SERVICES ARE SHOWN.



DES	DT	DARWIN REGION – ZUCCOLI ASPIRE LOT 13356 SUBDIVISION SEWER LONGITUDINAL PLAN		
DRN	DT			
CHK	SW			
APPD	SW			
SCALE	AS SHOWN			
ISSUED	A1	DRAWING NUMBER	B20-12360	6
ALL DIM. IN m				
DRAFTING STANDARD TO A.S.1100		CAD PRODUCT – DO NOT AMEND MANUALLY		AMDT