




4.5m VERGE - TYPE A STORMWATER PROPERTY CONNECTION
SCALE 1:25

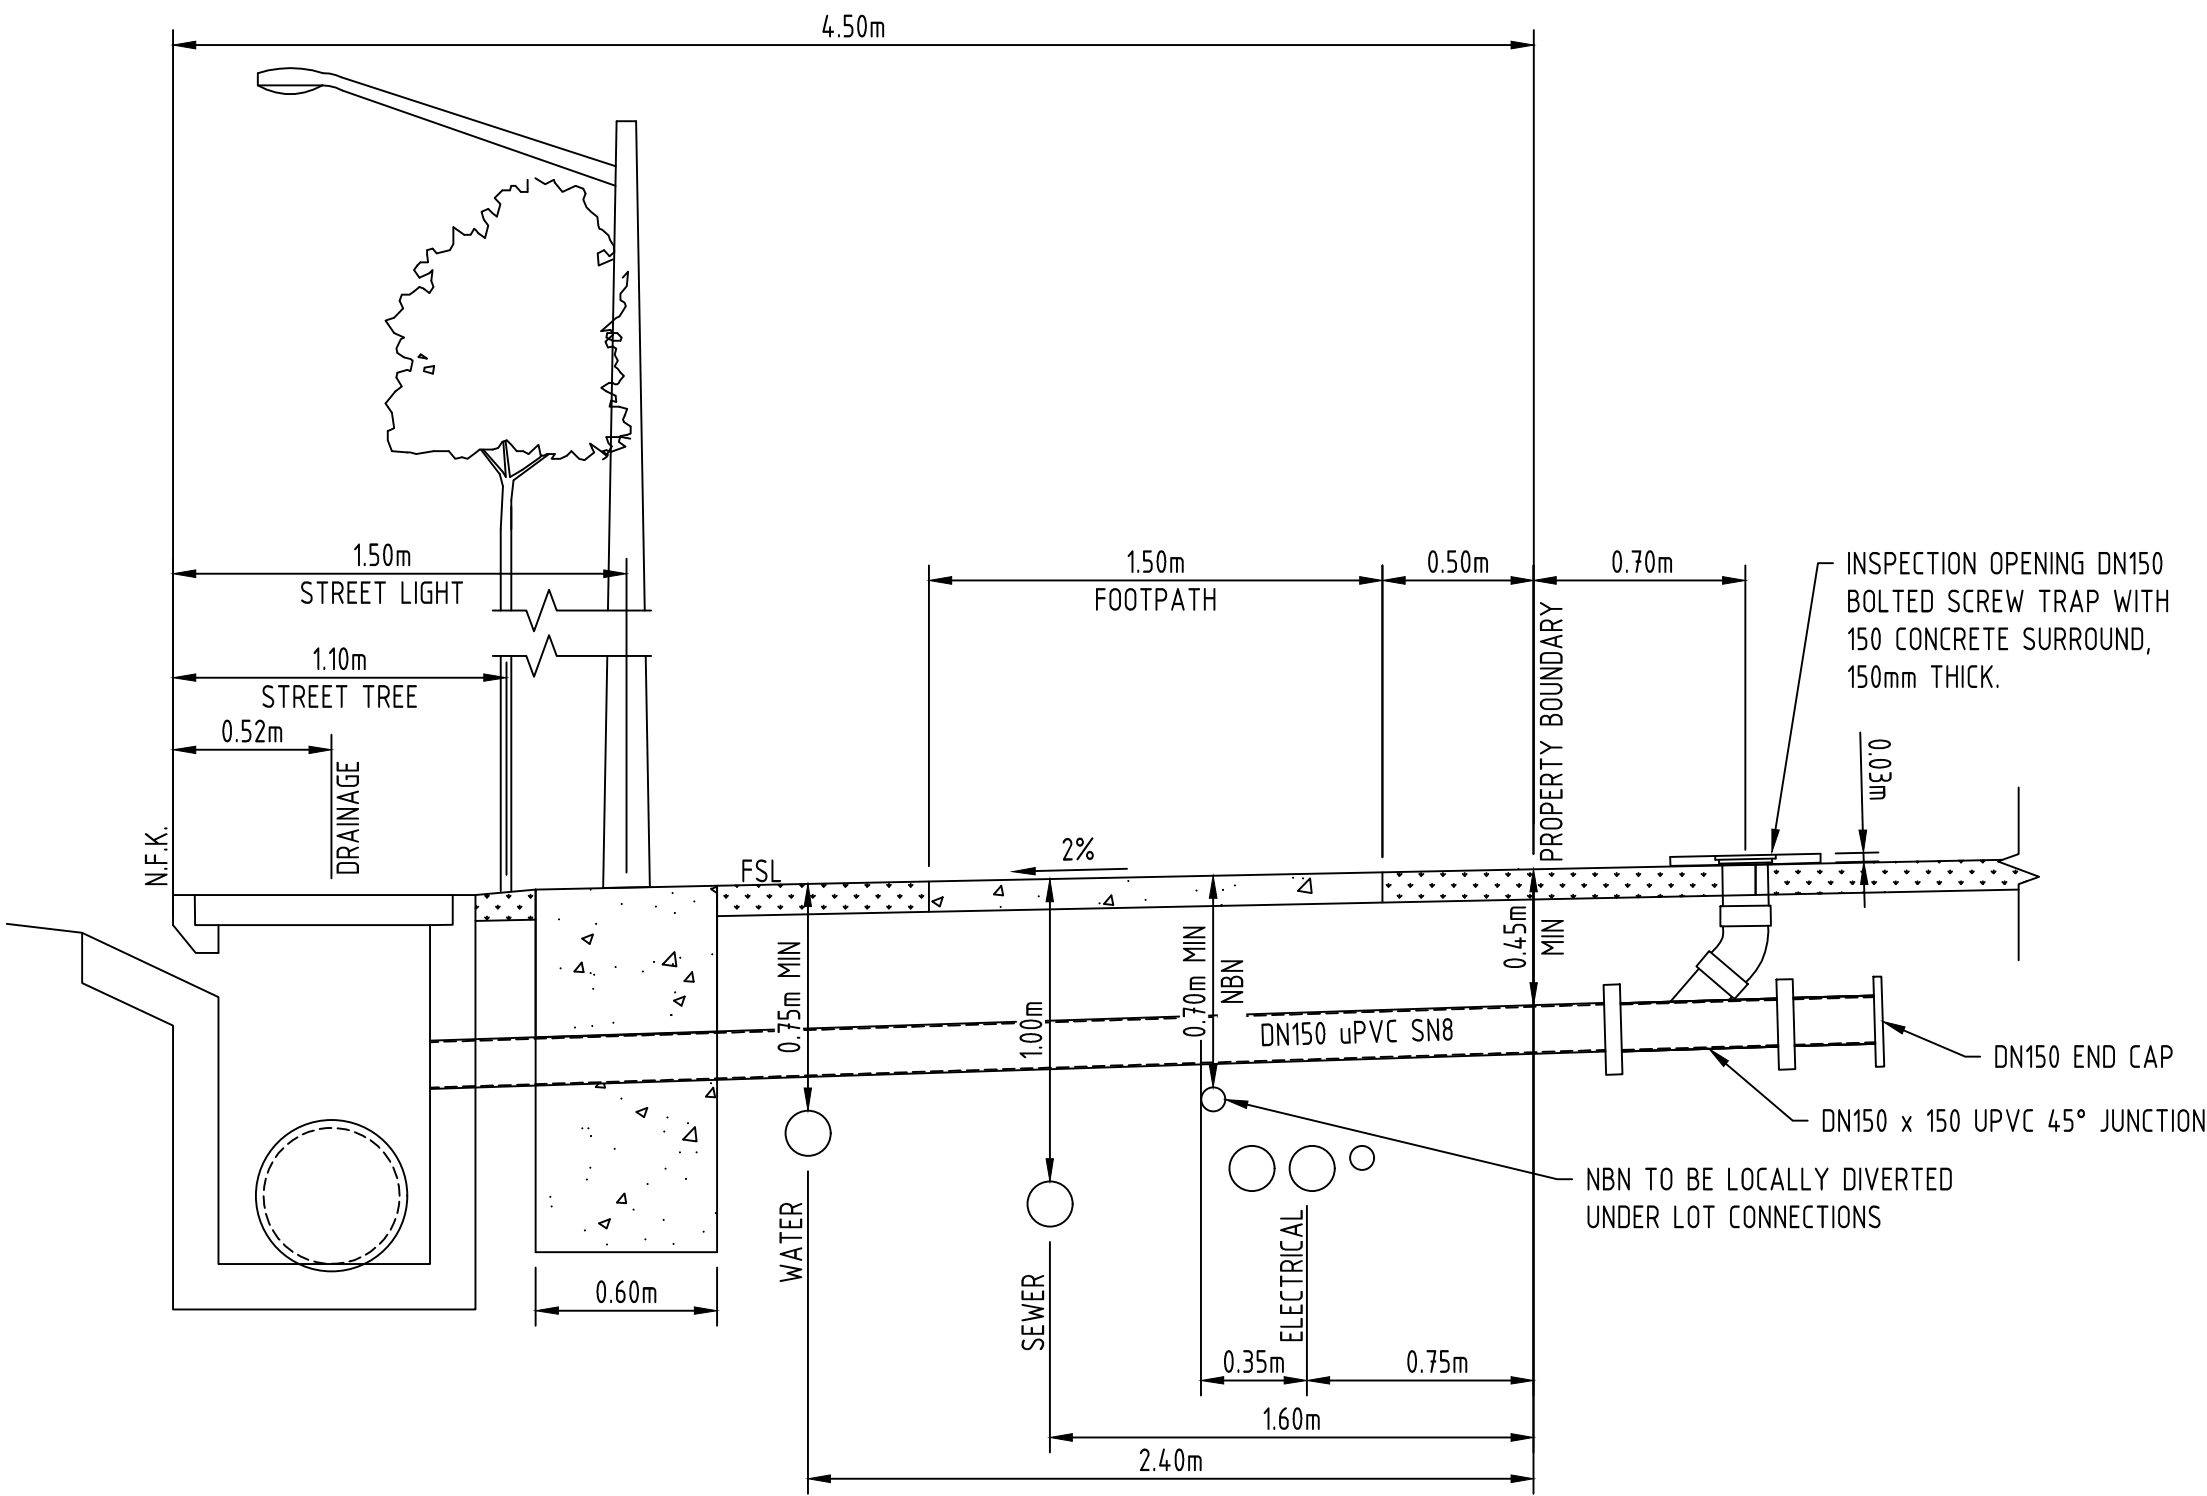

4.5m VERGE - TYPE B STORMWATER PROPERTY CONNECTION
SCALE 1:25

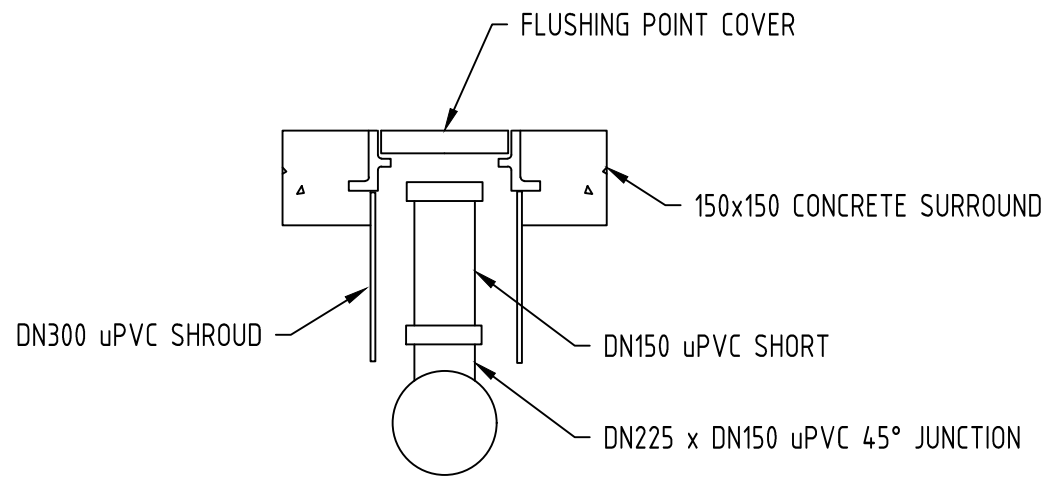

STORMWATER INSPECTION OPENING
N.T.S.

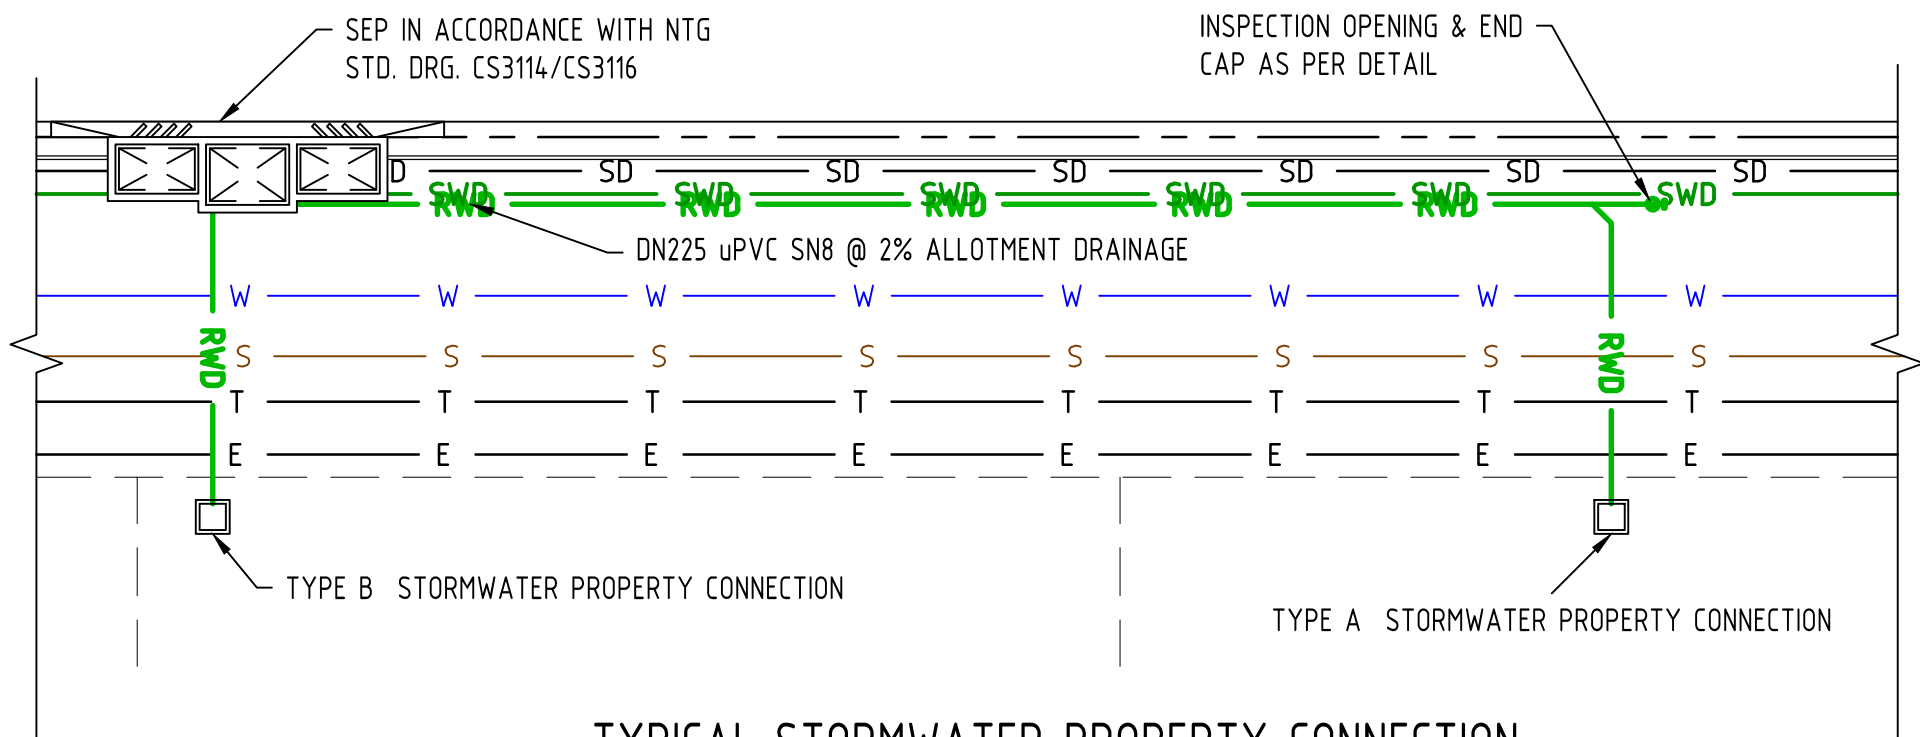

TYPICAL STORMWATER PROPERTY CONNECTION
SCALE 1:100

ALLOTMENT DRAINAGE COVER
ALLOTMENT DRAINAGE TO HAVE A MINIMUM COVER OF 450mm IN ACCORDANCE WITH TABLE 5.1 OF AS/NZS 2032.

DRAINAGE NOTES

- FOR GENERAL NOTES REFER TO DRG No. 13356_001, WHICH IS TO BE REQUESTED AND VIEWED PRIOR TO COMMENCEMENT OF CONSTRUCTION IF NOT SUPPLIED.
- FOR DRAINAGE LAYOUT PLAN REFER DRAWING 13356_300

PERMISSION TO USE FOR CONSTRUCTION PURPOSES
ROADWORKS AND STORMWATER DRAINAGE

SIGNED DATE

DIRECTOR OF TECHNICAL SERVICES - CITY OF PALMERSTON

This permission to use is given on the basis that the Developer and/or Consultant is not absolved from full responsibility for the correctness and accuracy of the design and/or documents associated. This permission is valid for two years from date of signing.

AS CONSTRUCTED

Rev	Date	Description	By	CHK
1	20.05.21	AS CONSTRUCTED	SFH	JL
0	28.09.20	ISSUED FOR CONSTRUCTION	DT	SW

PLOT DATE: 5/20/2021 2:52 PM FILENAME: J:\20000\20696\DW\DWG\LOT 13356 SUBDIVISION\20696_13356_301_ ALLOTMENT DRAINAGE DETAILS.DWG



Client: COSTOJIC PTY LTD	Discipline: CIVIL	Status: COSNTRUCTION	Title: ZUCCOLI ASPIRE LOT 13356 SUBDIVISION ALLOTMENT DRAINAGE DETAILS
Project Name: ZUCCOLI ASPIRE SUBDIVISION OF LOT 13356	Designed By: DT	Checked By: SW	Approved By: SW
	Project No.: 20696	Drawn By: DT	Scale at A1: AS SHOWN
The concepts and information contained in this document are the copyright of ADG Engineers (Aust) Pty Ltd. Use or copying of the document in whole or in part without the written permission of ADG Engineers (Aust) Pty Ltd constitutes an infringement of copyright. Do not scale drawings. If in doubt, ask!			Drawing No: 13356_301
			Revision: 1

FULL SIZE ON ORIGINAL 0 10 20 30 40 50 60 70 80 90 100mm