

DEPTH RANGE LEGEND

2.25+ m		FILL
2.00 to 2.25 m		
1.75 to 2.00 m		
1.50 to 1.75 m		
1.25 to 1.50 m		
1.00 to 1.25 m		
0.75 to 1.00 m		
0.50 to 0.75 m		
0.25 to 0.50 m		CUT
0.00 to 0.25 m		
-0.25 to 0.00 m		
-0.50 to -0.25 m		
-0.75 to -0.50 m		
-1.00 to -0.75 m		
-1.25 to -1.00 m		
-1.50 to -1.25 m		
-1.75 to -1.50 m		
-1.75+m		

LEGEND - EARTHWORKS

• 12.80	FINISHED SURFACE LEVEL
• 12.78 NS	NATURAL SURFACE LEVEL
— 17.0 —	SURFACE CONTOURS (0.2M INTERVAL)
✕ 12.84 0.01	AS CONSTRUCTED LEVEL VARIANCE FROM DESIGN

NOTES - EARTHWORKS

- ALL BATTERS AT FRONT OF LOTS TO BE 1 ON 6, UNLESS NOTED OTHERWISE.
- ALL BATTERS TO REAR AND SIDE BOUNDARIES TO BE 1 ON 2, UNLESS NOTED OTHERWISE. REFER DRG C340 FOR TYPICAL DETAILS.



WARNING
BEWARE OF SERVICES
The locations of all existing services are approximate only and their exact position should be proven on site. No guarantee is given that all existing services are shown.

AS CONSTRUCTED

NOTE:
REFER FLANAGAN CONSULTING GROUP DRG No.
4493-34-3-C337 - 4493-34-3-C339 FOR PREVIOUS ISSUES.

Rev	Date	Description	By	Chk
1	02.10.18	AS CONSTRUCTED - ADG	JMB	SW
0	12.07.17	ISSUED FOR CONSTRUCTION - FCG	LM	LM


0 10 20 30m
SCALE 1:500
AT ORIGINAL SIZE (A1)




Client
COSTOJIC PTY LTD
Project Name
ZUCCOLI ASPIRE
STAGE 3A
CIVIL WORKS

Discipline CIVIL	Status AS CON
Designed By SW	Checked By SW
Project No. 20696	Drawn By JMB
Approved By CJM	
Scale at A1 1:500	

Title EARTHWORKS LAYOUT PLAN SHEET 1 OF 3	
Drawing No. 3A_200	Revision 1

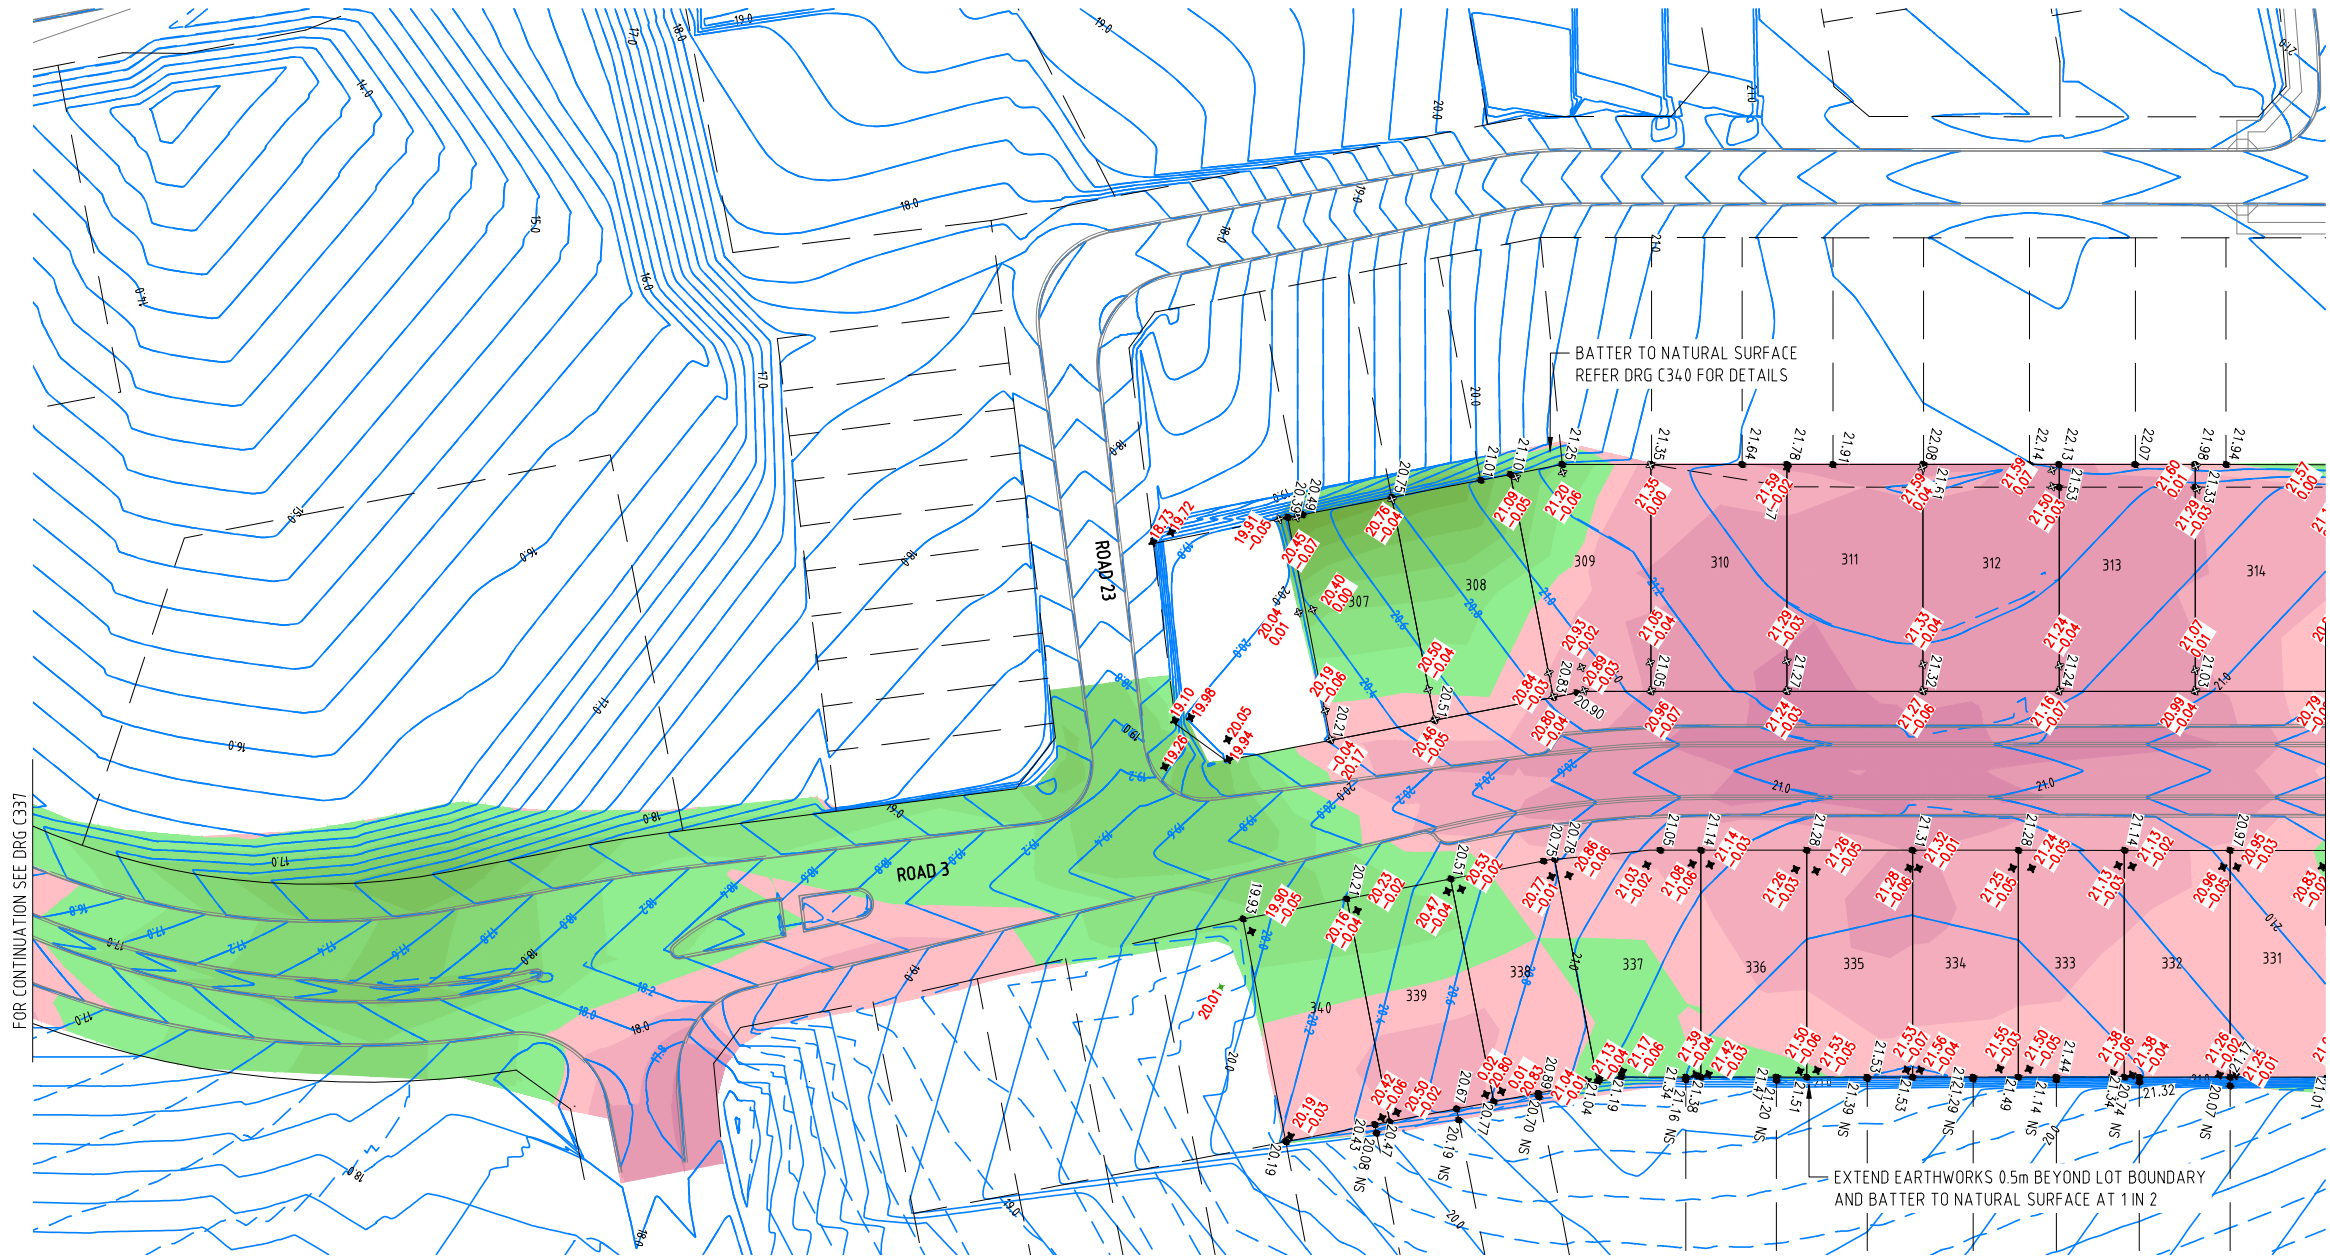

DEPTH RANGE LEGEND

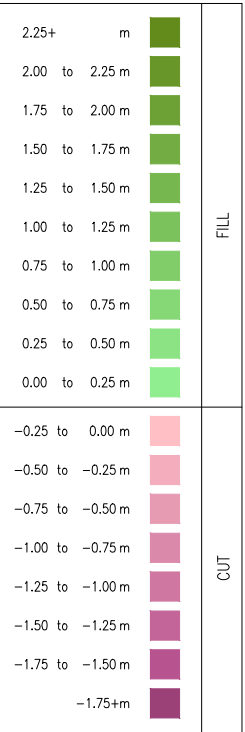

LEGEND - EARTHWORKS

- 12.80 FINISHED SURFACE LEVEL
- 12.78 NS NATURAL SURFACE LEVEL
- 17.0 — SURFACE CONTOURS (0.2M INTERVAL)
- ✕ 12.84 0.01 AS CONSTRUCTED LEVEL VARIANCE FROM DESIGN

NOTES - EARTHWORKS

- ALL BATTERS AT FRONT OF LOTS TO BE 1 ON 6, UNLESS NOTED OTHERWISE.
- ALL BATTERS TO REAR AND SIDE BOUNDARIES TO BE 1 ON 2, UNLESS NOTED OTHERWISE. REFER DRG C340 FOR TYPICAL DETAILS.



WARNING
BEWARE OF SERVICES
The locations of all existing services are approximate only and their exact position should be proven on site. No guarantee is given that all existing services are shown.

AS CONSTRUCTED

Rev	Date	Description	By	Chk
1	02.10.18	AS CONSTRUCTED - ADG	JMB	SW
0	12.07.17	ISSUED FOR CONSTRUCTION - FCG	LM	LM



Darwin Office
Tenancy 3, Level 1, 5 Edmunds Street,
Darwin, Northern Territory 0800, Australia
GPO Box 2422, Darwin, Northern Territory 0801
T 1300 657 402 F +617 3871 2266
E info@adgce.com W www.adgce.com
BRISBANE / DARWIN / GOLD COAST / MELBOURNE / PERTH /
SUNSHINE COAST / SYDNEY / TOOWOOMBA

Client
COSTOJIC PTY LTD

Project Name
ZUCCOLI ASPIRE
STAGE 3A
CIVIL WORKS

Discipline
CIVIL

Designed By
SW

Project No.
20696

Checked By
SW

Drawn By
JMB

Status
AS CON

Approved By
CJM

Scale at A1
1:500

Title
EARTHWORKS
LAYOUT PLAN
SHEET 2 OF 3

Drawing No.
3A_201

Revision
1

LEGEND - EARTHWORKS

- 12.80 FINISHED SURFACE LEVEL
- 12.78 NS NATURAL SURFACE LEVEL
- 17.0 — SURFACE CONTOURS (0.2M INTERVAL)
- ✕ 12.84 0.01 AS CONSTRUCTED LEVEL VARIANCE FROM DESIGN

NOTES - EARTHWORKS

- ALL BATTERS AT FRONT OF LOTS TO BE 1 ON 6, UNLESS NOTED OTHERWISE.
- ALL BATTERS TO REAR AND SIDE BOUNDARIES TO BE 1 ON 2, UNLESS NOTED OTHERWISE. REFER DRG C340 FOR TYPICAL DETAILS.

DEPTH RANGE LEGEND

2.25+ m		FILL
2.00 to 2.25 m		
1.75 to 2.00 m		
1.50 to 1.75 m		
1.25 to 1.50 m		
1.00 to 1.25 m		
0.75 to 1.00 m		
0.50 to 0.75 m		
0.25 to 0.50 m		CUT
0.00 to 0.25 m		
-0.25 to 0.00 m		
-0.50 to -0.25 m		
-0.75 to -0.50 m		
-1.00 to -0.75 m		
-1.25 to -1.00 m		
-1.50 to -1.25 m		
-1.75 to -1.50 m		
-1.75+m		



DIAL 1100
BEFORE YOU DIG

WARNING

BEWARE OF SERVICES

The locations of all existing services are approximate only and their exact position should be proven on site. No guarantee is given that all existing services are shown.

AS CONSTRUCTED

NOTE:
REFER FLANAGAN CONSULTING GROUP DRG No.
4493-34-3-C337 - 4493-34-3-C339 FOR PREVIOUS ISSUES.

Rev	Date	Description	By	Chk
1	02.10.18	AS CONSTRUCTED - ADG	JMB	SW
0	12.07.17	ISSUED FOR CONSTRUCTION - FCG	LM	LM

0 10 20 30m
SCALE 1:500
AT ORIGINAL SIZE (A1)



Client
COSTOJIC PTY LTD
Project Name
ZUCCOLI ASPIRE
STAGE 3A
CIVIL WORKS

Discipline CIVIL	Status AS CON
Designed By SW	Checked By CJM
Project No. 20696	Drawn By JMB

Title EARTHWORKS LAYOUT PLAN SHEET 3 OF 3	Revision 1
--	---------------