



SEWER NOTES:

1. REFER DRG B20-12357 FOR STANDARD NOTES.
2. ALL DIMENSIONS ARE IN MILLIMETERS U.N.O.
3. BENCH AND SHORE TRENCHES WHERE NECESSARY TO CONFORM TO SAFETY REQUIREMENTS OR AS DIRECTED BY A GEOTECHNICAL ENGINEER.
4. REFER SEWERAGE LONGITUDINAL SECTIONS FOR SEWER SETOUT, PIPE DIAMETERS AND TRENCH TYPES.
5. CONTRACTOR SHALL CONFIRM THE LEVEL OF ALL EXISTING SEWER CONNECTION POINTS PRIOR TO COMMENCING CONSTRUCTION. DISCREPANCIES TO BE REFERRED TO THE SUPERINTENDENT BEFORE PROCEEDING.
6. PROPERTY CONNECTIONS TO BE CONSTRUCTED IN ACCORDANCE WITH PWC STD DRGS W2-1-01 TO W2-1-10.
7. ACCESS CHAMBERS TO BE CONSTRUCTED IN ACCORDANCE WITH PWC STD DRGS W2-2-01A, W2-2-01D & W2-2-03.
8. MAINTENANCE SHAFTS TO BE CONSTRUCTED IN ACCORDANCE WITH PWC STD DRGS W2-2-07 & W2-2-08.
9. PIPE STUBS FOR FUTURE LINES SHALL INCLUDE THE STANDARD ACCESS CHAMBER FLEXIBLE JOINTS AND A PUSH-ON ENDCAP LOCATED AFTER THE SECOND JOINT.

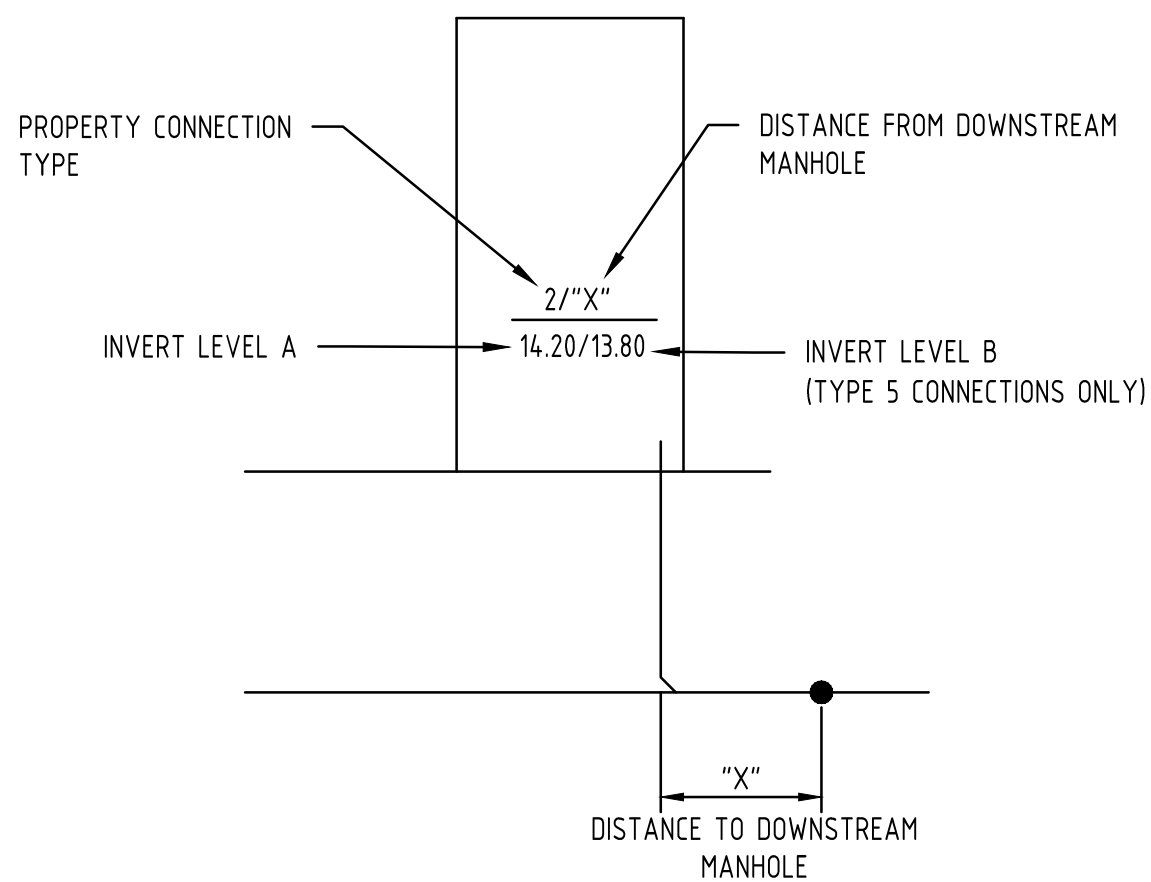


TYPICAL LOT CONNECTION WITH A ROAD CROSSING  
N.T.S.

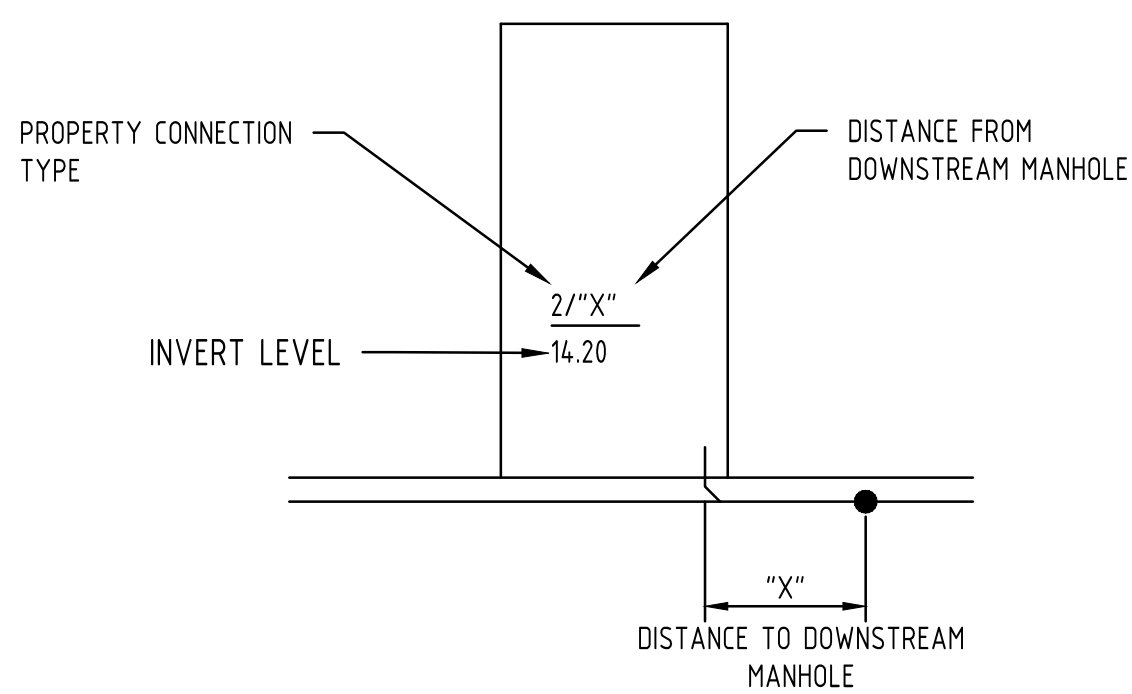


TYPICAL LOT CONNECTION SETOUT WITHOUT ROAD CROSSING


N.T.S.

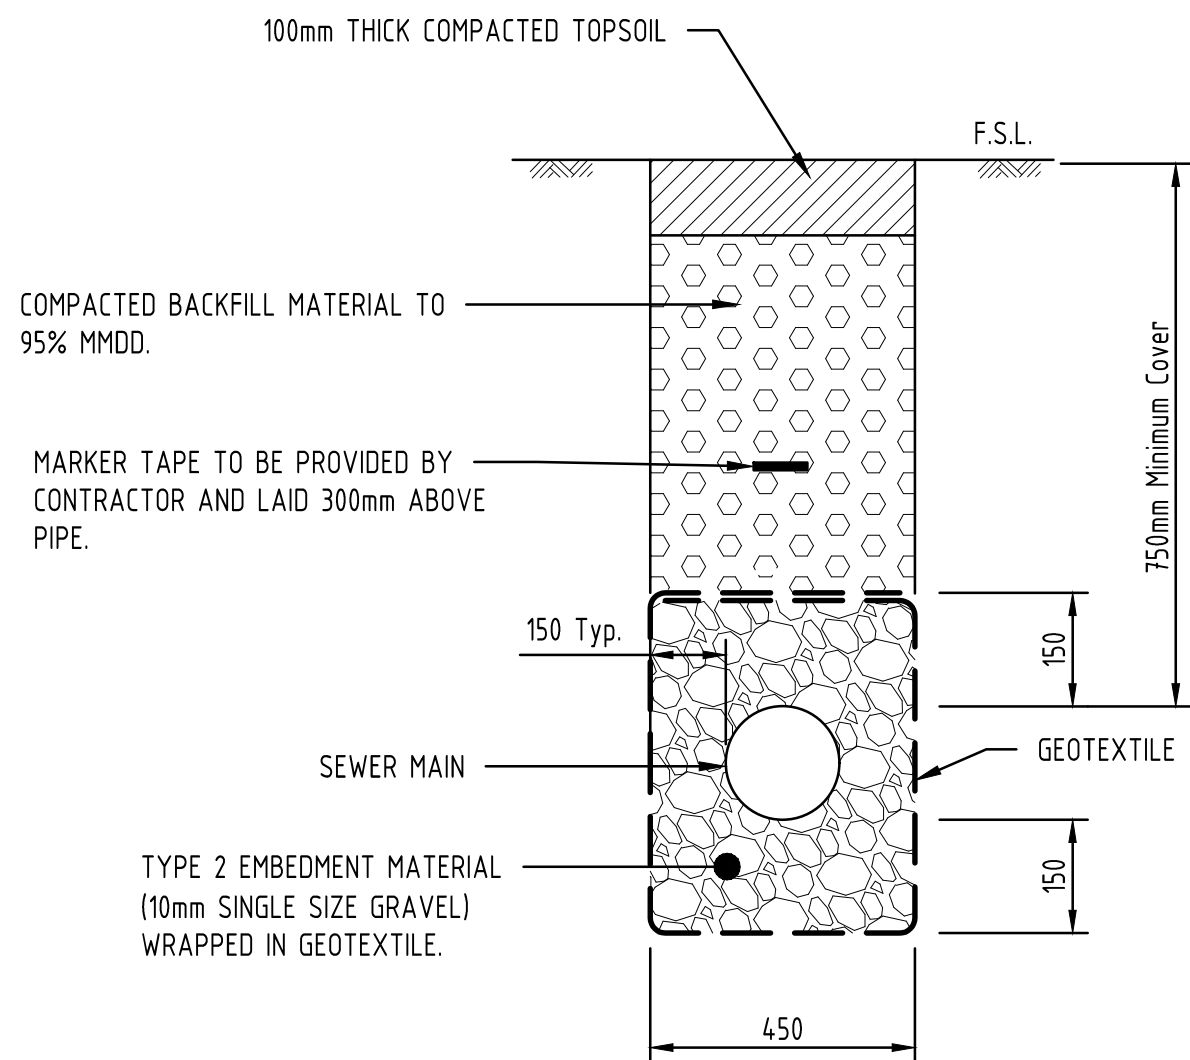


TRENCH DETAIL - TYPE B  
(STANDARD - UNDER VERGE)  
N.T.S.

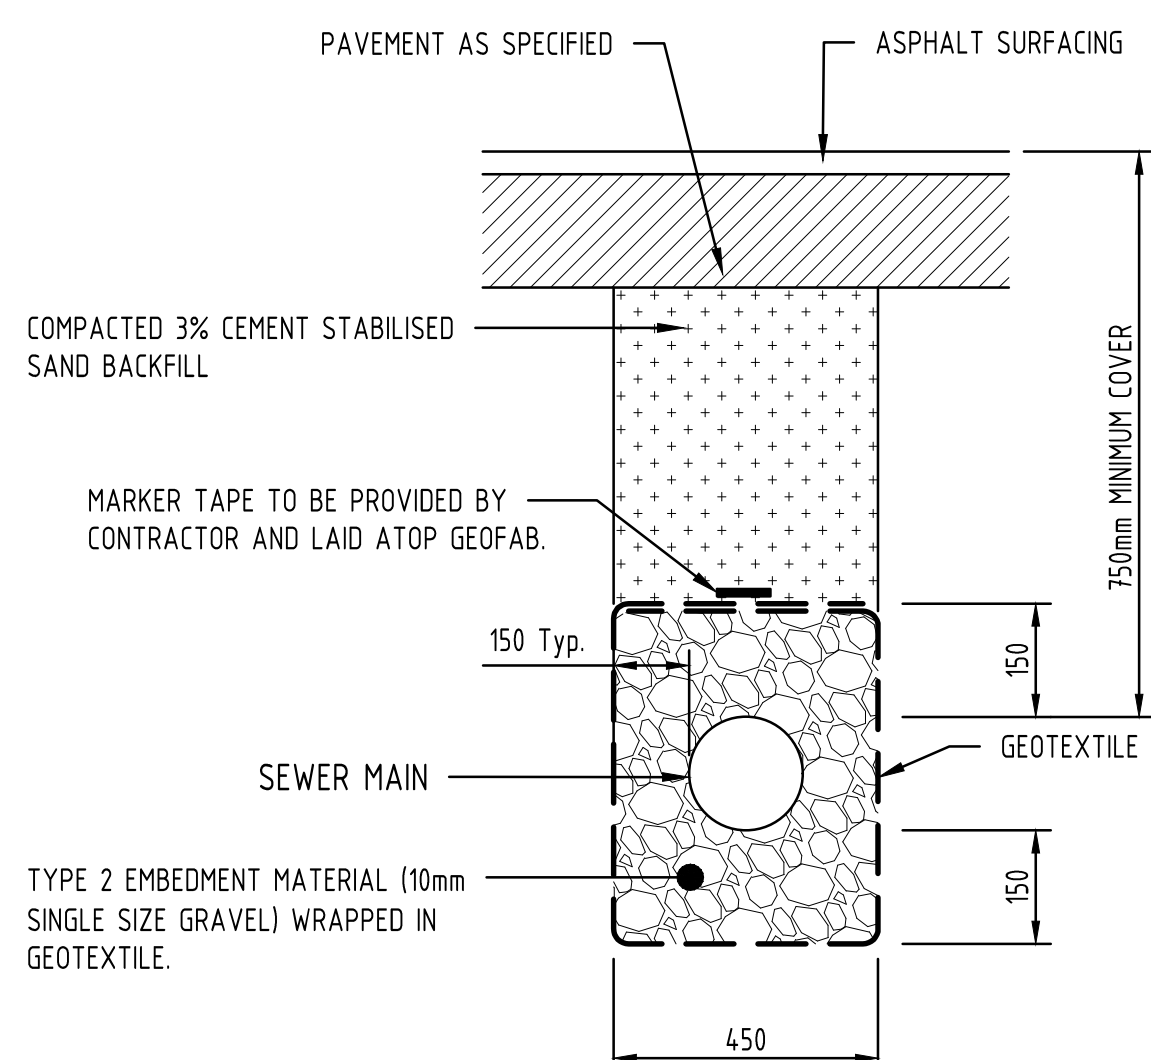


TRENCH DETAIL - TYPE C  
(STANDARD - UNDER ROAD PAVEMENTS)  
N.T.S.

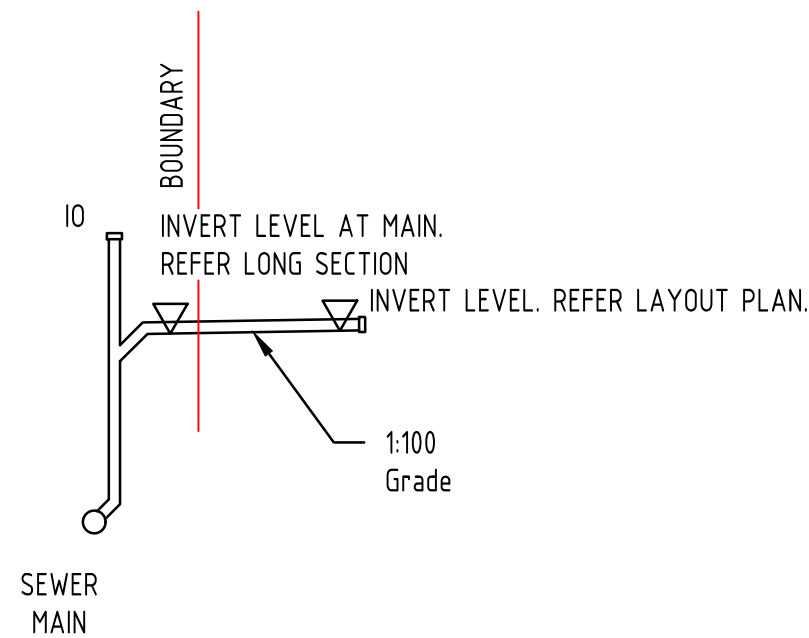

TYPE 2

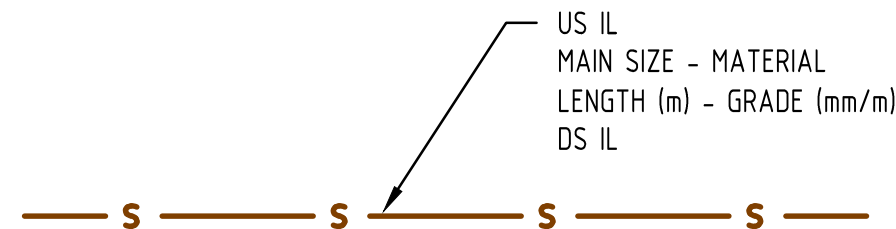

TYPICAL MAIN LABEL

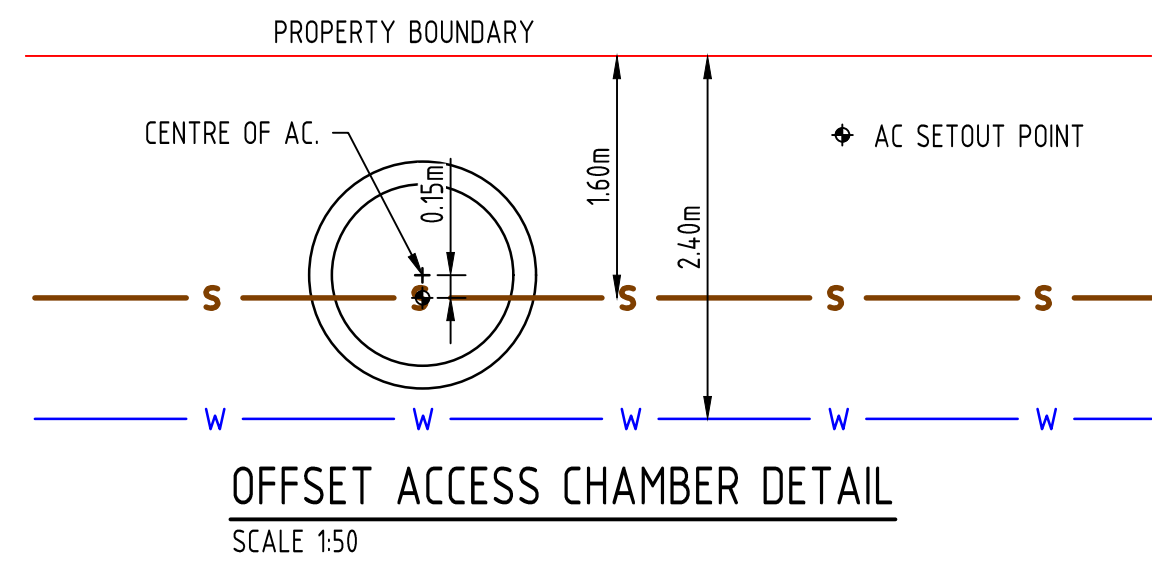


DESIGN CERTIFICATION


CERTIFIER'S NAME: SAM WARNER  
PWC ACCREDITATION CODE: DESCRTBL69  
DATE: 20.05.21 SIGNATURE: .....

PERMISSION TO USE FOR CONSTRUCTION PURPOSES ONLY  
SIGNED \_\_\_\_\_ DATE \_\_\_\_\_  
ON BEHALF OF WATER SERVICES FOR THE INCORPORATION  
INTO POWER AND WATER CORPORATION'S NETWORK.  
This permission to use this approved design is given on the  
Basis that the developer and/or consultant is not absolved  
From full responsibility for the correctness and accuracy or  
Of the design and/or documents so associated.

This drawing is valid for 2 years from the date of signing

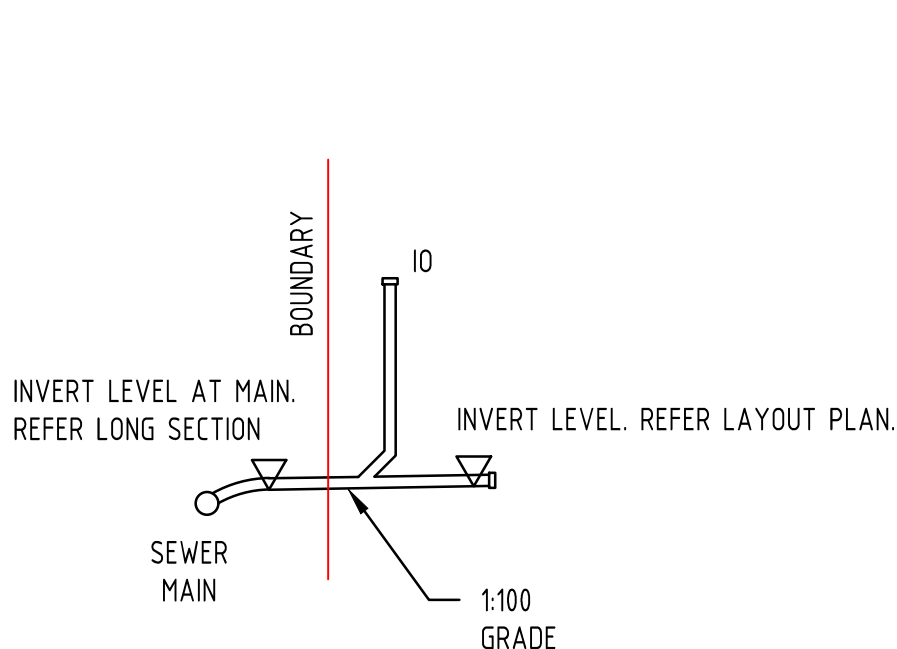

TYPE 1

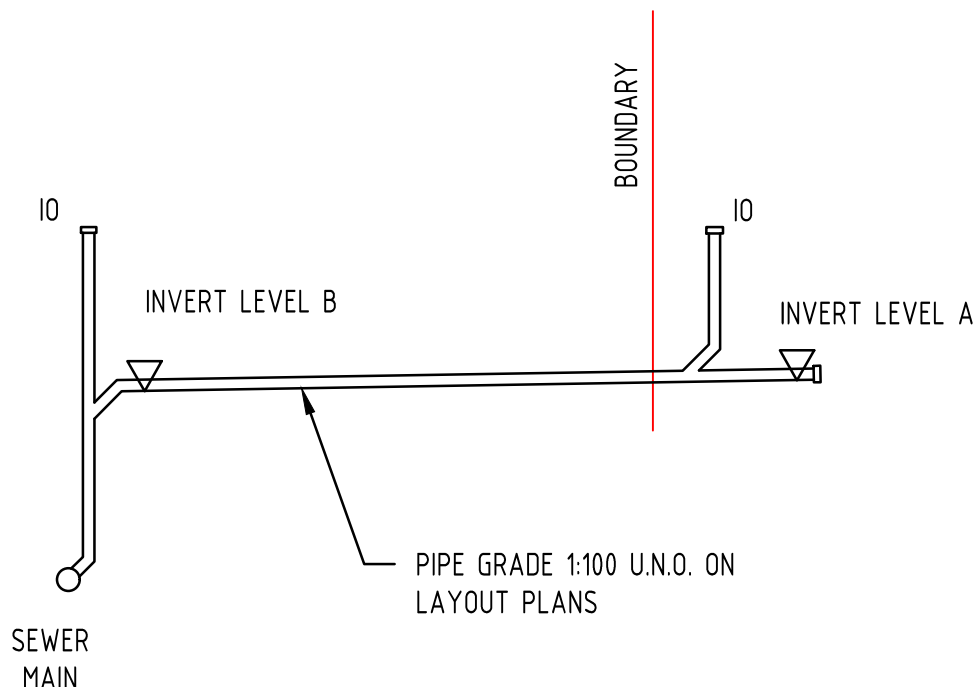

TYPE 5

TYPICAL ELEVATIONS TYPE 1, 2 & 5 - PROPERTY CONNECTION DETAILS

N.T.S.

\* NOTE, THESE DETAILS ARE SCHEMATIC ONLY AND REFERENCE SHALL BE MADE TO THE RELEVANT PWC STANDARD DRAWINGS FOR EACH CONNECTION TYPE



SCALE 150

AT ORIGINAL SIZE (A1)

ADG PROJECT 20696 DRG No. 13356\_501

ISSUED FOR  
CONSTRUCTION

NO	DESCRIPTION	DRN	DATE	CKD	APPD
1	AS CONSTRUCTED	SFH	20.05.21	JL	SW
0	ISSUED FOR CONSTRUCTION	DT	28.09.20	SW	SW
AMENDMENTS					



**WARNING**  
**BEWARE OF SERVICES**  
THE LOCATIONS OF ALL EXISTING SERVICES ARE APPROXIMATE ONLY AND THEIR EXACT POSITION SHOULD BE PROVEN ON SITE. NO GUARANTEE IS GIVEN THAT ALL EXISTING SERVICES ARE SHOWN.



DES	DT	DARWIN REGION - ZUCCOLI ASPIRE LOT 13356 SUBDIVISION SEWER NOTES & DETAILS	
DRN	DT		
CHK	SW		
APPD	SW		
SCALE	AS SHOWN		
ISSUED	A1	DRAWING NUMBER	B20-12358
ALL DIM. IN m			
DRAFTING STANDARD TO A.S.1100		CAD PRODUCT - DO NOT AMEND MANUALLY	
			1 AMD