

DETAIL 1
NTS

WARNING ⚠

EXISTING HIGH VOLTAGE SERVICES WITHIN THE VICINITY OF REQUIRED WORKS. FOR ALL WORK WITHIN 2.5m OF MAJOR CABLES, THE CONTRACTOR IS REQUIRED TO HAND DIG (POTHOLE) AND EXPOSE THE CABLE/CONDUIT BEFORE WORK CAN COMMENCE. ON SITE LOCATION SHOULD BE SOUGHT FROM AN ACCREDITED PLANT LOCATOR. ALL EXISTING SERVICES CROSSING PROPOSED WORKS TO HAVE DEPTHS CONFIRMED AS PER DESIGN DRAWINGS BEFORE COMMENCEMENT OF WORKS. ANY DISCREPANCIES TO BE REPORTED PRIOR TO COMMENCEMENT OF WORKS.

- NOTE**
- FOR NOTES & LEGEND REFER TO DRG No. B20-12361
 - ALL LIVE CONNECTIONS TO BE PERFORMED BY PWC CONTRACTOR.
 - WATER PROPERTY CONNECTIONS TO BE CONSTRUCTED IN ACCORDANCE WITH PWC STD DRAWINGS W1-1-01A.
 - ALL PROPERTY WATER SERVICE CONNECTIONS SHALL BE 20mm SIZE U.N.O
 - FOR THRUST BORING DETAILS FOR ZUCCOLI PARADE REFER TO PWC STD DRG No. W1-1-33

SAFETY IN DESIGN REPORT

ARE THERE ANY ADDITIONAL HAZARDS/RISKS NOT NORMALLY ASSOCIATED WITH THE TYPES OF WORK DETAILED ON THIS DRAWING

☐ NO

☒ YES - THRUST BORING
- WORKS WITHIN VICINITY OF LIVE HV

EXISTING SERVICES NOTE

EXISTING SERVICES PLOTTED FROM RECORDS AND 'O.B.Y.D.' LOCATION AND LEVEL OF ALL EXISTING SEWER SERVICES ARE BASED ON INFORMATION PROVIDED BY FLANAGAN CONSULTING GROUP AS CONSTRUCTED DATA DATED 06/07/2016 AND ARE TO BE CONFIRMED ON SITE PRIOR TO CONSTRUCTION. CONTRACTOR TO CONTACT 'DIAL BEFORE YOU DIG' FOR THE LOCATION OF EXISTING PUBLIC UTILITIES PRIOR TO EXCAVATION. ANY DAMAGE TO EXISTING SERVICES WILL BE REPAIRED AT THE CONTRACTORS EXPENSE.

PERMISSION TO USE FOR CONSTRUCTION PURPOSES ONLY

SIGNED _____ DATE _____

ON BEHALF OF WATER SERVICES FOR THE INCORPORATION INTO POWER AND WATER CORPORATION'S NETWORK.

This permission to use this approved design is given on the basis that the developer and/or consultant is not absolved from full responsibility for the correctness and accuracy or of the design and/or documents so associated.


This drawing is valid for 2 years from the date of signing

DESIGN CERTIFICATION

CERTIFIER'S NAME: SAM WARNER

PWC ACCREDITATION CODE: DESCRTBL69

DATE: 20.05.21 SIGNATURE: _____

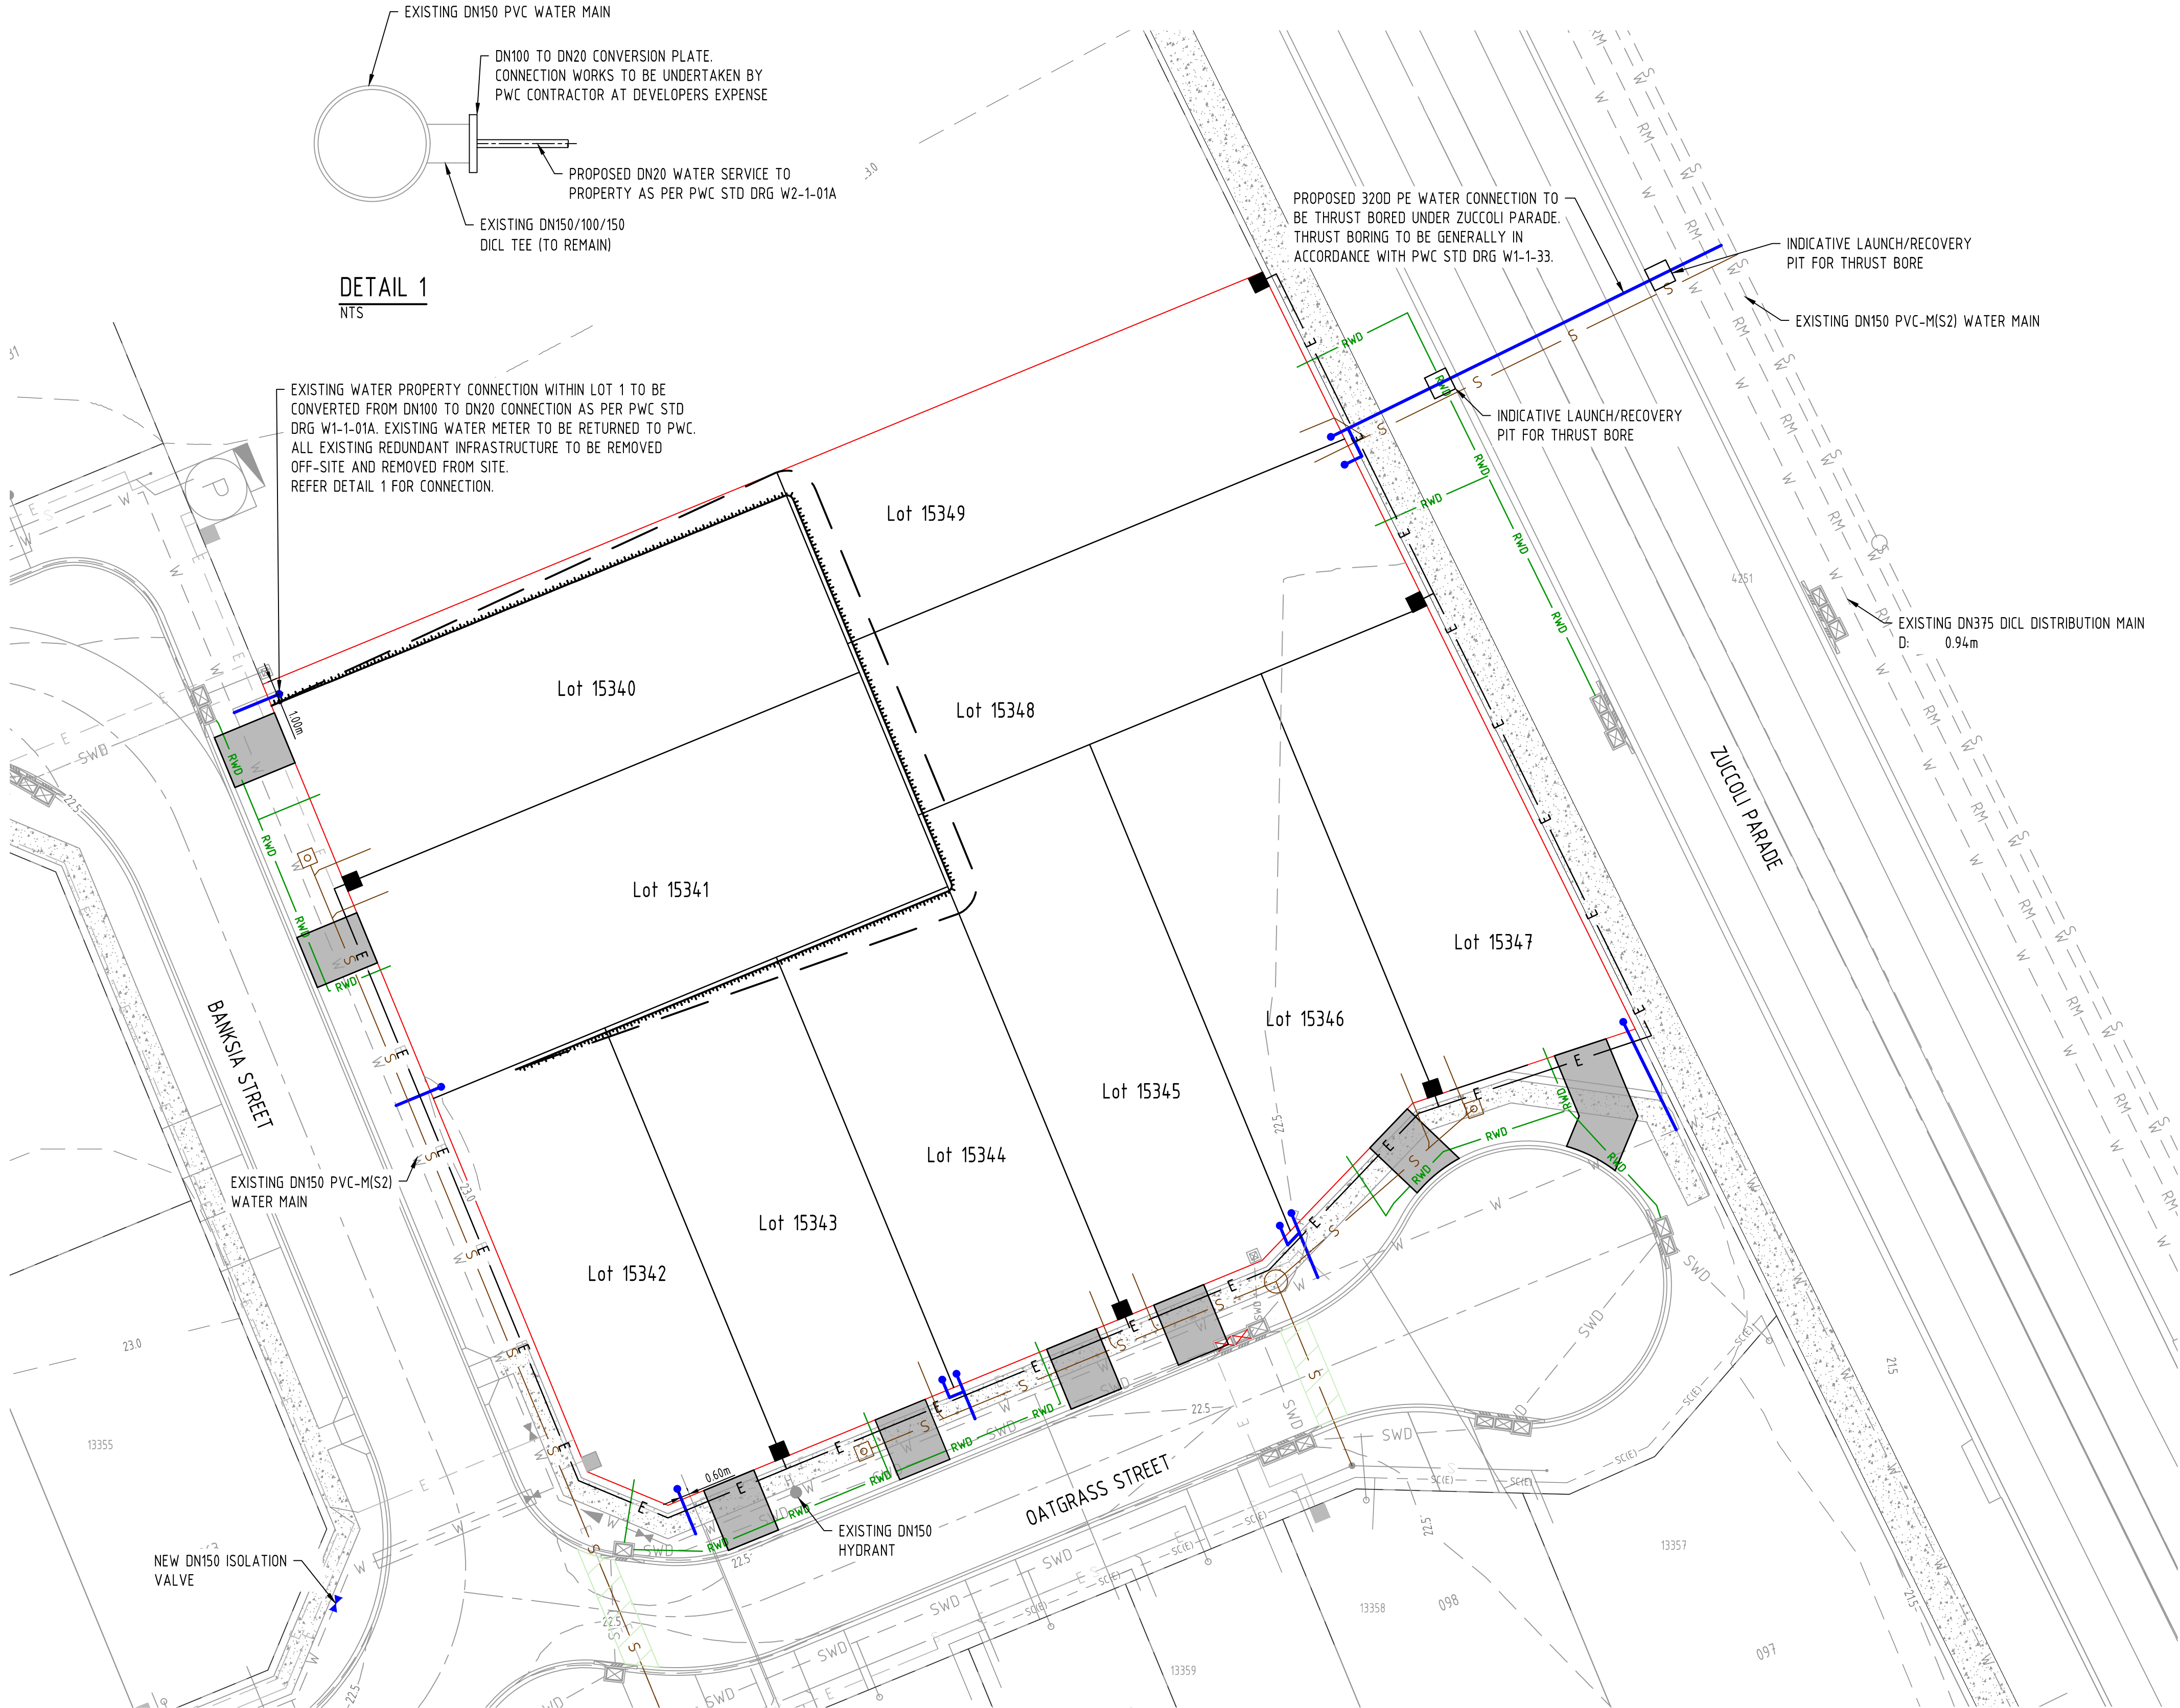

AT ORIGINAL SIZE (A1)

AS CONSTRUCTED

ADG PROJECT 20696 DRG No. 13356_601

NO	DESCRIPTION	DRN	DATE	CKD	APPD
1	AS CONSTRUCTED	SFH	20.05.21	JL	SW
0	ISSUED FOR CONSTRUCTION	DT	28.09.20	SW	SW
AMENDMENTS					



WARNING
BEWARE OF SERVICES

THE LOCATIONS OF ALL EXISTING SERVICES ARE APPROXIMATE ONLY AND THEIR EXACT POSITION SHOULD BE PROVEN ON SITE. NO GUARANTEE IS GIVEN THAT ALL EXISTING SERVICES ARE SHOWN.



DES	DT	DARWIN REGION - ZUCCOLI ASPIRE LOT 13356 SUBDIVISION WATER LAYOUT PLAN		
DRN	DT			
CHK	SW			
APPD	SW			
SCALE	1:250			
ISSUED		A1	DRAWING NUMBER	B20-12362
ALL DIM. IN m			CAD PRODUCT - DO NOT AMEND MANUALLY	1 AMDT
DRAFTING STANDARD TO A.S.1100				