



PROVIDED FOR INFORMATION PURPOSES ONLY  
AND SHOULD NOT BE USED FOR CONSTRUCTION  
- BUILDERS/BUYERS ARE TO INFORM THEMSELVES

LEGEND

- SITE BOUNDARY
- DESIGN SURFACE CONTOURS
- EXISTING SURFACE CONTOURS
- EXISTING STORMWATER DRAINAGE
- EXISTING STORMWATER STRUCTURE
- EXISTING SEWER
- EXISTING SEWER PROPERTY CONNECTION
- EXISTING SEWER MAINTENANCE HOLE OR ACCESS CHAMBER
- EXISTING WATER
- EXISTING WATER PROPERTY CONNECTION
- EXISTING WATER HYDRANT
- EXISTING WATER VALVE
- EXISTING UNDERGROUND ELECTRICITY
- EXISTING STREETLIGHT
- LIMIT OF WORKS
- LOT BOUNDARY
- PROPOSED LAYBACK KERB & GUTTER
- PROPOSED UPRIGHT KERB & GUTTER
- PROPOSED STORMWATER DRAINAGE PIPE
- PROPOSED SIDE ENTRY PIT
- PROPOSED SEWER
- PROPOSED SEWER MANHOLE
- PROPOSED SEWER ACCESS CHAMBER
- PROPOSED SEWER PROPERTY CONNECTION AND IO CONCRETE SURROUND
- PROPOSED WATER MAIN
- PROPOSED WATER PROPERTY CONNECTION
- PROPOSED WATER HYDRANT
- PROPOSED WATER VALVE
- PROPOSED STORMWATER PROPERTY CONNECTION DN225
- PROPOSED STORMWATER PROPERTY CONNECTION DN150
- PROPOSED ROOFWATER PROPERTY PIT
- PROPOSED ELECTRICAL
- PROPOSED ROAD CENTRE LINE
- PROPOSED ELECTRICAL PROPERTY CONNECTION
- PROPOSED NBN PIT
- DRIVEWAY SETOUT POINTS
- PROPOSED STREET SIGN
- PROPOSED STREETLIGHT
- PROPOSED DRIVEWAY LOCATION
- PROPOSED FOOTPATH IN ACCORDANCE WITH CoP. STANDARDS
- PROPOSED ASPHALT PAVEMENT
- INTERSECTION - 40mm ASPHALT PAVEMENT
- PROPOSED KERB RAMP. REFER SDG STD DRG SS1009 FOR DETAILS.
- PROPOSED SUBSOIL DRAIN
- PROPOSED SUBSOIL DRAINAGE CLEAN OUT POINT
- DN50 IRRIGATION CONDUIT

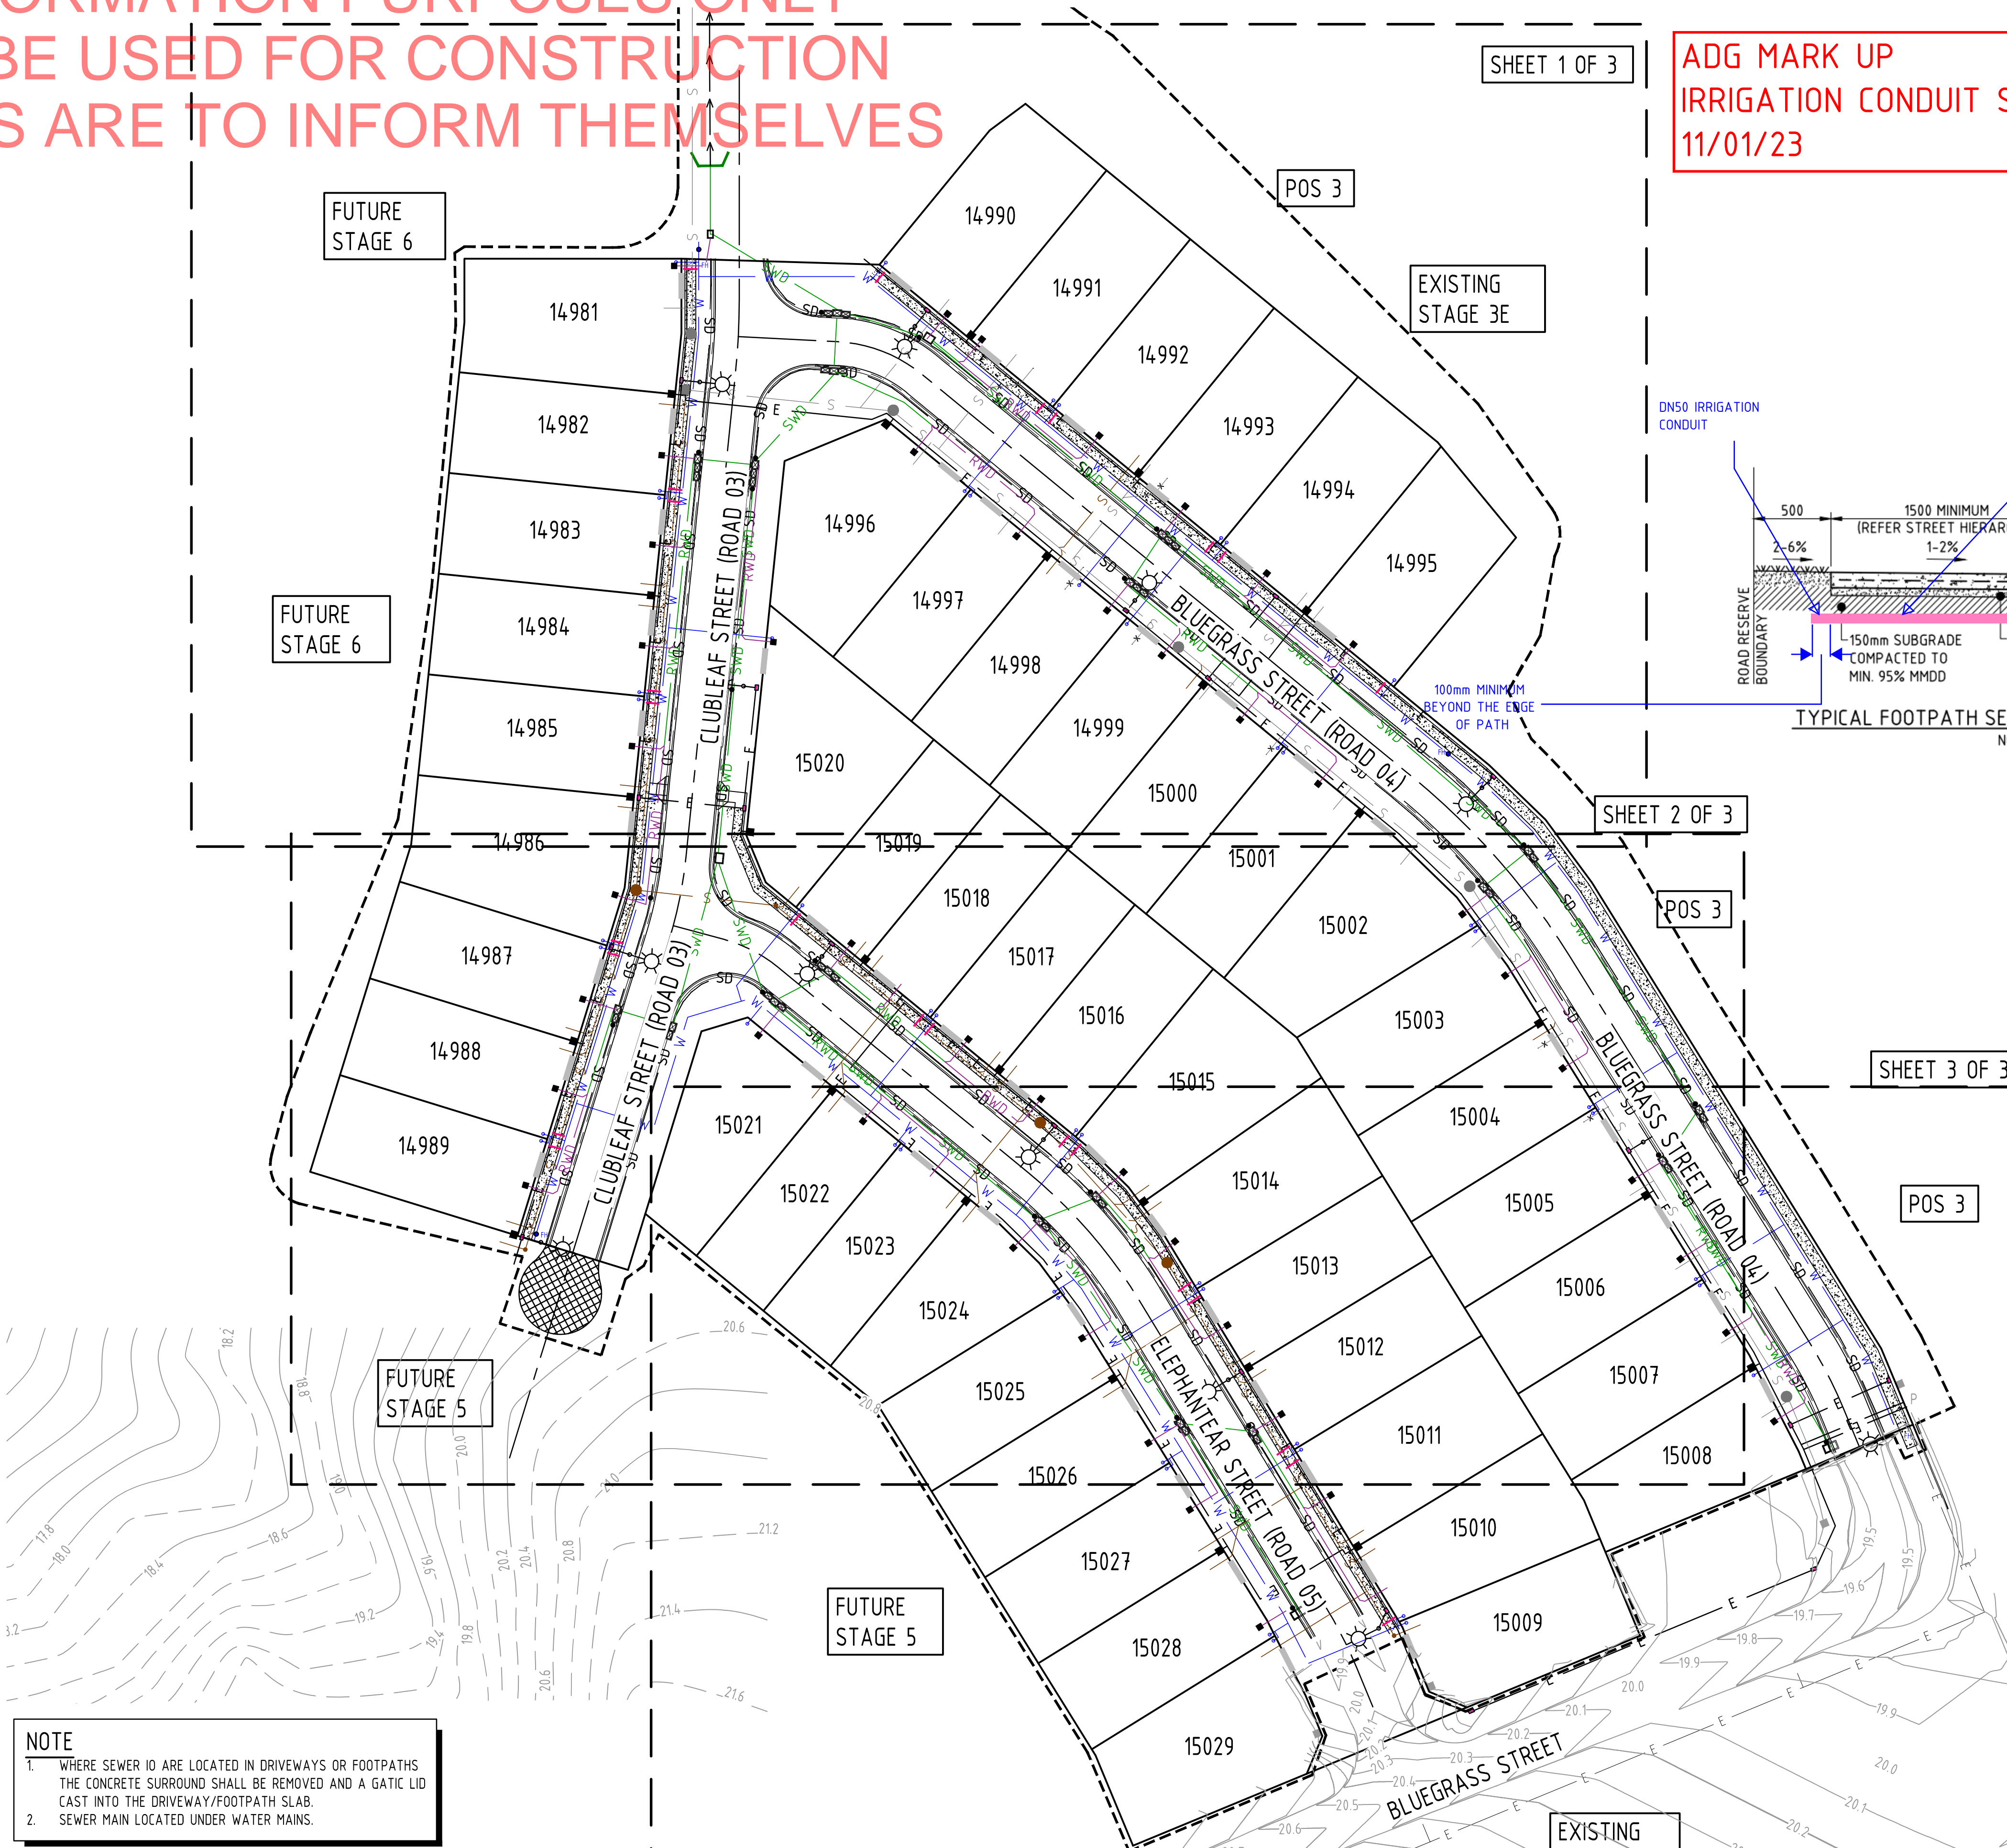

ADG MARK UP  
IRRIGATION CONDUIT SITE INSTRUCTION  
11/01/23

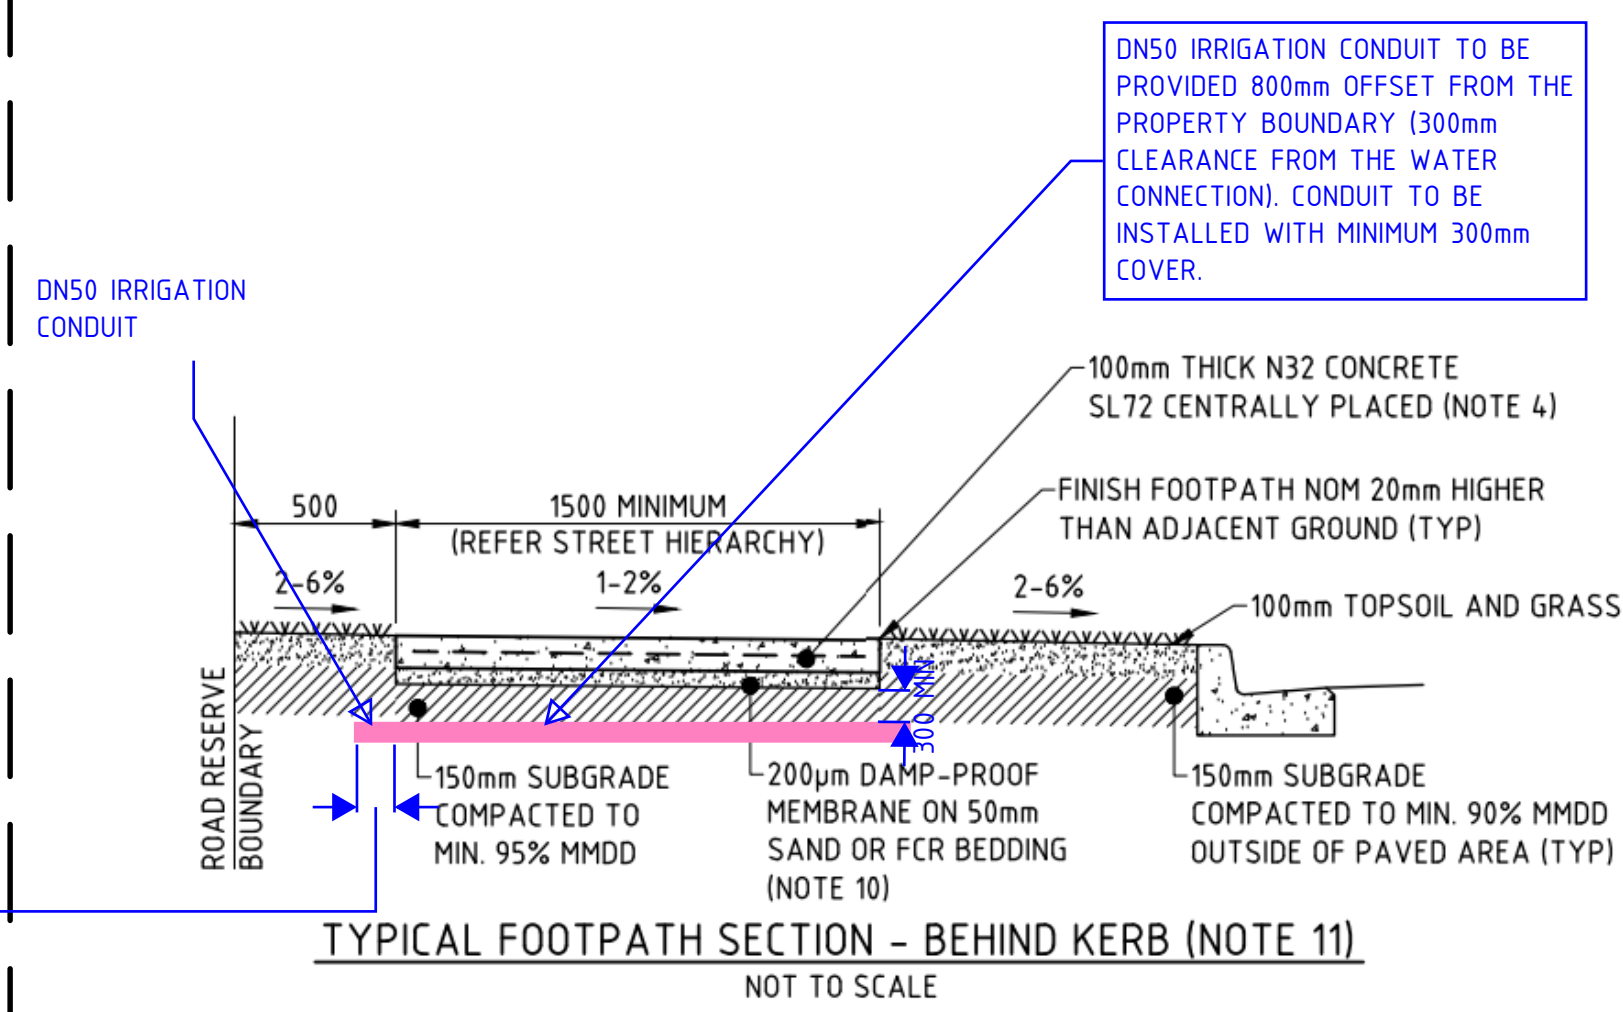

NOTE  
1. WHERE SEWER IO ARE LOCATED IN DRIVEWAYS OR FOOTPATHS THE CONCRETE SURROUND SHALL BE REMOVED AND A GATIC LID CAST INTO THE DRIVEWAY/FOOTPATH SLAB.  
2. SEWER MAIN LOCATED UNDER WATER MAINS.

PERMISSION TO USE FOR CONSTRUCTION PURPOSES  
ROADWORKS AND STORMWATER DRAINAGE  
SIGNED \_\_\_\_\_ DATE \_\_\_\_\_  
GENERAL MANAGER INFRASTRUCTURE - CITY OF PALMERSTON  
This permission to use is given on the basis that the Developer and/or Consultant is not absolved from full responsibility for the correctness and accuracy of the design and/or documents associated. This permission is valid for two years from date of signing.

Rev	Date	Description	By	Chk
0	15.09.22	ISSUED FOR CONSTRUCTION	AB	HD

0 10 20 30m  
SCALE 1500  
AT ORIGINAL SIZE (A1)

**ZUCCOLI**  
aspire

**ADG**  
T:1300 657 402 E: info@adgco.com W: www.adgco.com  
Quality Assurance ISO 9001:2015 | Work Health Safety ISO 45001:2018  
Environmental Management ISO 14001:2015

Client: COSTOJIC PTY LTD  
Project Name: ZUCCOLI ASPIRE STAGE 3D CIVIL WORKS

Discipline: CIVIL	Checked By: JLB	Status: CONSTRUCTION
Designed By: JMB	Drawn By: AB	Approved By: HD
Project No: 20696		Scale at A1: 1:500

The concepts and information contained in this document are the copyright of ADG Engineers (Aust) Pty Ltd. Use or copying of the document in whole or in part without the written permission of ADG Engineers (Aust) Pty Ltd constitutes an infringement of copyright. Do not scale drawings. If in doubt, ask!

Issued For Construction

MASTER SERVICES OVERALL LAYOUT

Drawing No: 3D\_700  
Revision: 0